

HAR.  
M 439  
7-21-61

WATER WELL DRILLERS LOG

**CODED**

Date: July 21, 1961, Driller: C. T. SWITZER WELL CO. County Harrison  
(Name)

(1) Owner of Land: M E Lucky  
(Name)  
Shorecrest Road  
(Address)

(2) Location: 1/4, 1/4, Sec. T R  
8 710  
miles of  
(distance) (direction) (Nearest Town)

(3) Topography: X  
(Hilly) (Flat) (Level)

(4) Purpose of Well: Domestic  
(Domestic Irrigation  
Municipal, Industrial, Other)

Description & Color of Materials Sand, Clay, Red Clay, Shell, etc.	Thick- ness Feet	Depth Feet
<u>clay</u>	<u>0</u>	<u>10</u>
<u>sand</u>	<u>10</u>	<u>30</u>
<u>clay</u>	<u>30</u>	<u>51</u>
<u>sand</u>	<u>51</u>	<u>93</u>

Information upon completion of well:

(1) Diameter 2" inches.

(2) Total Depth 93' feet.

(3) Water Level 26' feet below top of ground.

(4) Cased to 93', Size 2"


(5) Screen: Size 2" , Length 10'

(6) Were any formations sealed against pollution?  
X yes, \_\_\_\_\_ no.

If YES depth of formation \_\_\_\_\_  
Why Health Dept Required

Drillers Remarks: \_\_\_\_\_

**CODED**

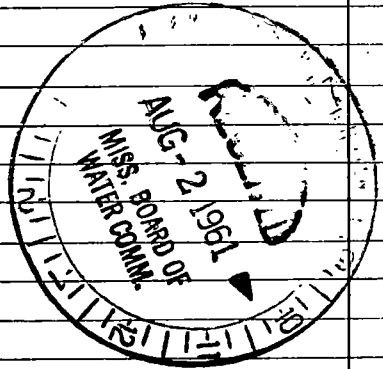

(Use Back Side)

Well No.

