

M441  
10-11-61

WATER WELL DRILLERS LOG

<sup>11-306</sup>  
**CODED**

Date: 10-11, 1961, Driller: C. T. SWITZER WELL CO. County Harrison

(Name)

(1) Owner of Land: Ralph Gregory  
(Name)  
Bilbo Mbs  
(Address)

(2) Location: 3 1/4 7 10  
1/4, 1/4, Sec. T R  
\_\_\_\_\_ miles \_\_\_\_\_ of \_\_\_\_\_  
(distance) (direction) (Nearest Town)

(3) Topography: X  
(Hilly) (Flat) (Level)

(4) Purpose of Well: Domestic  
(Domestic Irrigation  
Municipal, Industrial, Other)

Description & Color of Materials Sand, Clay, Red Clay, Shell, etc.	Thick- ness Feet	Depth Feet
clay	0	8
sand & gravel	8	23
sand	23	33
clay	33	45
sand	45	83
clay	83	271
sand	271	287

**CODED**

Information upon completion of well:

(1) Diameter 2" inches.

(2) Total Depth 287' feet.


(3) Water Level 9' feet below top of ground.

(4) Cased to 287', Size 2"

(5) Screen: Size 2", Length 10'

(6) Were any formations sealed against pollution?  
X yes, \_\_\_\_\_ no.

If YES depth of formation \_\_\_\_\_  
Why Health Dept Requirement  
Drillers Remarks: \_\_\_\_\_

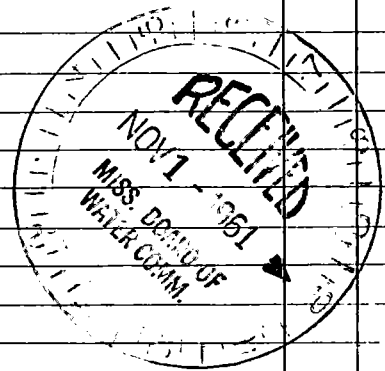

(Use Back Side)

Well No.

