

HAR.

MISSISSIPPI BOARD OF WATER COMMISSIONERS

M442

11-9-61

WATER WELL DRILLERS LOG

CODED 370

Date: 11-9, 1961, Driller: C. T. SWITZER WELL CO. County Harrison

(Name)

(1) Owner of Land: H. B. Smouden (Name)

1956 Ross Road, Hardscrabble (Address)

(2) Location: 7 7/10 Sec. T. R.

miles of (distance) (direction) (Nearest Town)

(3) Topography: X (Hilly) (Flat) (Level)

(4) Purpose of Well: Domestic (Domestic Irrigation, Municipal, Industrial, Other)

Description & Color of Materials Sand, Clay, Red Clay, Shell, etc.

Thick-ness Feet

Depth Feet

Sand	00	41
Clay	41	62
Sand & Gravel	62	83
Sand	83	88
Clay	88	209
Sand	209	224
Fine Clay	224	230
Clay	230	251
Sand	251	261
Clay	261	272
Sand	272	298

Information upon completion of well:

(1) Diameter 2" inches.

(2) Total Depth 298' feet.

(3) Water Level 25 feet below top of ground.

(4) Cased to 135', Size 2"

(5) Screen: Size 2", Length 15'

(6) Were any formations sealed against pollution?


X yes, no.

If YES depth of formation

Why Health Dept. Requirement

Drillers Remarks:

CODED

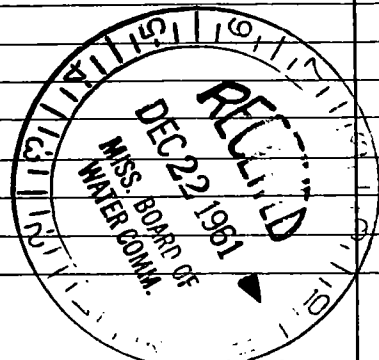

(Use Back Side)

Well No.

