

M444
7-11-60

D 5513 CODED 320
WATER WELL DRILLERS LOG

Date: July 11, 1960, Driller: C. J. Switzer Well Co. County: Harrison
(Name)

(1) Owner of Land: Percy Connor
1/8 mile N. of intersection of (Name)
Gay Road & Popps Ferry Rd. (Address)
(2) Location: 1/4, 1/4, Sec. 8 T17R9W
1/2 miles WN Tommy, of Tommy
(distance) (direction) (Nearest Town)
(3) Topography: ✓
(Hilly) (Flat) (Level)
(4) Purpose of Well: domestic
(Domestic Irrigation
Municipal, Industrial, Other)

| Description & Color of Materials Sand, Clay, Red Clay, Shell, etc. | Thick- ness Feet | Depth Feet |
|---|------------------------|---------------|
| <u>Top soil</u> | | <u>5</u> |
| <u>sand</u> | <u>5</u> | <u>15</u> |
| <u>Clay</u> | <u>15</u> | <u>48</u> |
| <u>sand</u> | <u>48</u> | <u>101</u> |
| <u>Clay</u> | <u>101</u> | <u>578</u> |
| <u>sand</u> | <u>578</u> | <u>588</u> |
| <u>Clay & rock</u> | <u>588</u> | <u>734</u> |
| <u>good sand</u> | <u>734</u> | <u>783</u> |
| <u>stratified sand</u> | <u>783</u> | <u>797</u> |
| <u>good sand</u> | <u>797</u> | <u>828</u> |


Information upon completion of well:

(1) Diameter 2 inches.
(2) Total Depth 826' feet.
(3) Water Level 2' feet below top of ground.
(4) Cased to 826', Size 2"
(5) Screen: Size 10 gauge Length 30'
(6) Were any formations sealed against pollution?
✓ yes, _____ no.

If YES depth of formation 10 feet
Why Health dept. requirement

Drillers Remarks: _____

CODED

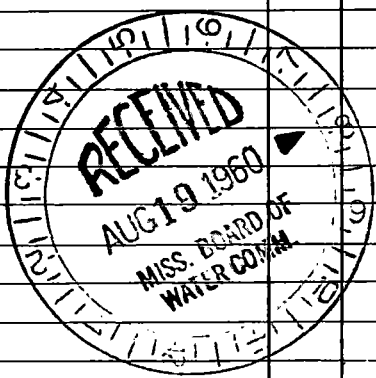

(Use Back Side)

Well No.

