

HAR.

M 447

5-29-62

MISSISSIPPI BOARD OF WATER COMMISSIONERS

WATER WELL DRILLERS LOG

CODED

Date: 5-29, 1962, Driller: C. T. SWITZER WELL CO County Harrison

(Name)

(1) Owner of Land: Mr. Myrtle Walker

(Name)

Box 1, Shreveport, Bienville

(Address)

(2) Location: 1/4, 1/4 Sec. 7 T 10 R

 miles, of (Nearest Town)

(3) Topography: ✓ (Level)

(4) Purpose of Well: Domestic
(Domestic Irrigation, Municipal, Industrial, Other)

Description & Color of Materials Sand, Clay, Red Clay, Shell, etc.	Thick- ness Feet	Depth Feet
Clay	00	40
Sand, good	40	78
Clay	78	120
Sand, fine	120	140
Clay	140	200
Sand	200	211
Clay	211	380
Clay few sand str	380	400
Clay	400	440
Sand, good	440	510

Information upon completion of well:

(1) Diameter 2" inches.

(2) Total Depth 510' feet.

(3) Water Level 1' feet below top of ground.

(4) Cased to 510', Size 2"

(5) Screen: Size 2", Length 10'

(6) Were any formations sealed against pollution?


✓ yes, no.

If YES depth of formation

Why Health Dept. Requirement

Drillers Remarks:

CODED

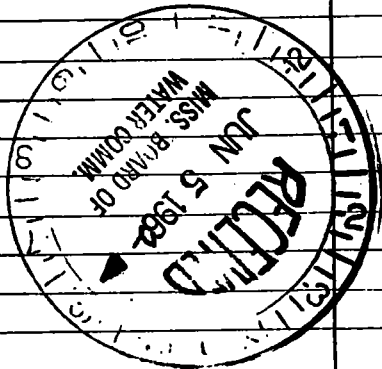

(Use Back Side)

Well No.

1000

1000

Faint, illegible text covering the majority of the page, possibly bleed-through from the reverse side.