

HAR.
M449
6-1-62

MISSISSIPPI BOARD OF WATER COMMISSIONERS

WATER WELL DRILLERS LOG

CODED

(?)

Date: 6-1, 1962, Driller: C. T. SWITZER WELL CO County Harrison

(Name)

(1) Owner of Land: C. W. Downing
(Name)

Box 767, Biloxi
(Address)

(2) Location: 1/4, 17 7 10, Sec. T R

 miles of
(distance) (direction) (Nearest Town)

(3) Topography:
(Hilly) (Flat) (Level)

(4) Purpose of Well: Domestic
(Domestic Irrigation
Municipal, Industrial, Other)

Description & Color of Materials Sand, Clay, Red Clay, Shell, etc.	Thick- ness Feet	Depth Feet
Clay	00	60
Sand, fine	60	100
Clay	100	180
Sand, fine	180	200
Clay	200	300
Sand, fine	300	320
Clay	320	432
Sand	432	440
Sand, good	440	510


Information upon completion of well:

- (1) Diameter 2 inches.
- (2) Total Depth 510 feet.
- (3) Water Level 5' feet below top of ground.
- (4) Cased to 510, Size 2"
- (5) Screen: Size 2", Length 10'
- (6) Were any formations sealed against pollution?
 yes, no.

If YES depth of formation
Why Health Dept. Requirements

Drillers Remarks:

CODED

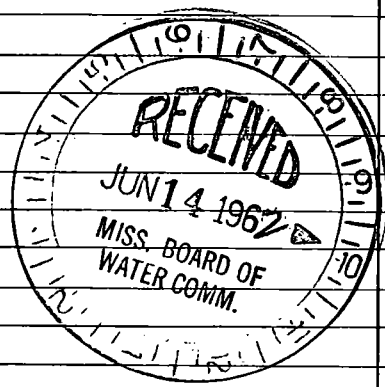

Handwritten title at the top of the page, possibly "The ... of ...".

Main body of handwritten text, appearing to be a list or series of entries, possibly including names and dates.

Second section of handwritten text, continuing the list or entries from the first section.

Final section of handwritten text at the bottom of the page, possibly a conclusion or signature.