

HAR.
M453
7-16-62

MISSISSIPPI BOARD OF WATER COMMISSIONERS

M A 104305

WATER WELL DRILLERS LOG

CODED (9)

Date: 7-16, 1962, Driller: C. T. SWITZER WELL CO. County Harrison
(Name)

(1) Owner of Land: M. M. Moss
(Name)
Qt. 1, Box 313, Boloxi
(Address)

(2) Location: 1/4, 9 79, Sec. T R
_____ miles _____ of _____
(distance) (direction) (Nearest Town)

(3) Topography: (Hilly) (Flat) (Level)

(4) Purpose of Well: Domestic
(Domestic Irrigation
Municipal, Industrial, Other)

Description & Color of Materials Sand, Clay, Red Clay, Shell, etc.	Thick- ness Feet	Depth Feet
Clay	00	20
Clay & sand str	20	40
Sand & Red Clay	40	60
Clay	60	80
Sand, fine	80	116
Clay	116	156
Sand	156	166
Clay	166	190
Sand	190	196
Kelly Sand prod	196	214

Information upon completion of well:

(1) Diameter 2 inches.

(2) Total Depth 214 feet.

(3) Water Level 14' feet below top of ground.


(4) Cased to 212', Size 2"

(5) Screen: Size 2", Length 10'

(6) Were any formations sealed against pollution?
 yes, no.

CODED

If YES depth of formation _____
Why Health Dept. Requirement
Drillers Remarks: _____

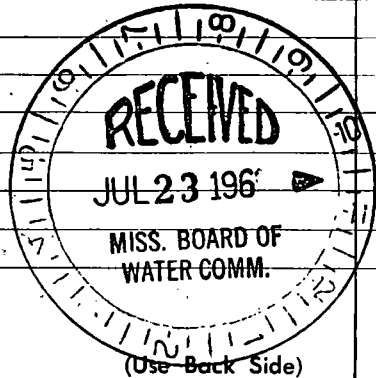

Well No.

1875

1875

