

M 454 M

8-22-62

WATER WELL DRILLERS LOG

**CODED**

Date: 9-22, 1962, Driller: C. T. SWITZER WELL CO. County: Harrison  
(Name)

- (1) Owner of Land: Bill Howard  
(Name)
- 211 Bay 14, Gulfport  
(Address)
- (2) Location: 19.8 7 10  
1/4, 1/4, Sec. T R
- miles of  
(distance) (direction) (Nearest Town)
- (3) Topography:  (Hilly)  (Flat)  (Level)
- (4) Purpose of Well: Domestic  
(Domestic Irrigation, Municipal, Industrial, Other)

Description & Color of Materials Sand, Clay, Red Clay, Shell, etc.	Thick- ness Feet	Depth Feet
Clay	00	40
Sand	40	60
Sand & Shovel	60	100
Sand, red	100	120
Sand & Shovel	120	180
Clay	180	260
Sand & clay shes	260	290
Sand, good	280	325

Information upon completion of well:


- (1) Diameter 2 inches.
- (2) Total Depth 325 feet.
- (3) Water Level 11' feet below top of ground.
- (4) Cased to 325', Size 2"
- (5) Screen: Size 2", Length 10'
- (6) Were any formations sealed against pollution?  
 yes,  no.

**CODED**

If YES depth of formation \_\_\_\_\_

Why Health Dept Requirements

Drillers Remarks: \_\_\_\_\_

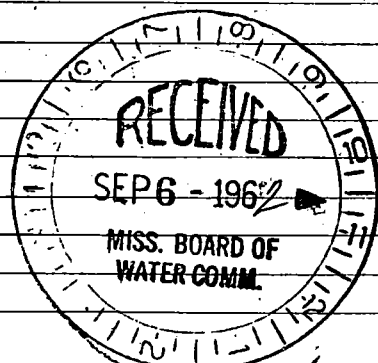

(Use Back Side)

Well No.

