

M 456 A 104 704

WATER WELL DRILLERS LOG

CODED

C. T. SWITZER WELL CO.

Date: 9-10, 1962, Driller: County Harrison

(Name)

(1) Owner of Land: Blasman Gas Co.
 (Name)
Highway 64, Biloxi
 (Address)

(2) Location: 9 79
 (distance) 1/4 miles, 9 79 (direction) T R of _____ (Nearest Town)

(3) Topography: ✓
 (Hilly) (Flat) (Level)

(4) Purpose of Well: Domestic
 (Domestic Irrigation
 Municipal, Industrial, Other)

Description & Color of Materials Sand, Clay, Red Clay, Shell, etc.	Thick- ness Feet	Depth Feet
Clay	00	50
Sand	50	55
Clay	55	80
Sand	80	94
Clay	94	140
Clay, few sand str	140	160
Clay	160	320
Sand, good	320	375

Information upon completion of well:

(1) Diameter 12 inches.

(2) Total Depth 375' feet.

(3) Water Level 11' feet below top of ground.

(4) Cased to 375', Size 3"

(5) Screen: Size 3", Length 20'


(6) Were any formations sealed against pollution?
 yes, no.

If YES depth of formation _____

Why Health Dept. Requirements

Drillers Remarks: _____

CODED

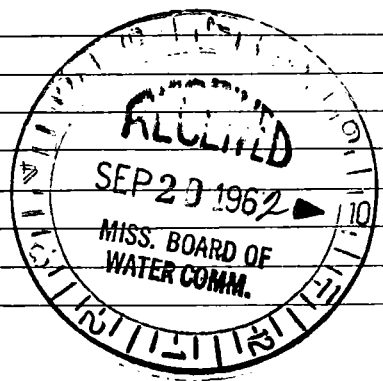

(Use Back Side)

Well No.

COPIED

[The remainder of the page contains extremely faint and illegible text, likely bleed-through from the reverse side of the document.]