

HAR.
M459
6-6-63

WATER WELL DRILLERS LOG

CODED

D28058
C. T. SWITZER WELL CO.

Date: 6-6, 1963 Driller: [Signature] County: Nacogdoches

(Name)

(1) Owner of Land: Jack A. East
(Name)
US Battlefield Ave, Balize
(Address)
24 7 10
(2) Location: 1/4, 1/4, Sec. T R
_____ miles _____ of _____
(distance) (direction) (Nearest Town)
(3) Topography: (Hilly) (Flat) (Level)
(4) Purpose of Well: Domestic
(Domestic Irrigation
Municipal, Industrial, Other)


Description & Color of Materials Sand, Clay, Red Clay, Shell, etc.	Thick- ness Feet	Depth Feet
Sand	00	10
Clay	40	60
Sand & fine shells	60	90
Sand, gravel	80	130
Clay	130	258
Sand	258	260
Clay	260	320
Clay & sand shales	320	340
Clay	340	350
Sand	350	360
Sand, fine	360	380
Clay	380	400
Sand, gravel	400	450

Information upon completion of well:

(1) Diameter 2 inches.
(2) Total Depth 450 feet.
(3) Water Level 10' feet below top of ground.
(4) Cased to 450', Size 2"
(5) Screen: Size 2", Length 10'
(6) Were any formations sealed against pollution?
 yes, _____ no.

If YES depth of formation _____
Why Health Dept. requirement
Drillers Remarks: _____

CODED

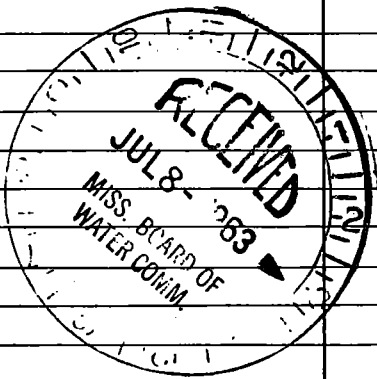

(Use Back Side)

Well No.

