

HAR.

M 460
7-2-63

WATER WELL DRILLERS LOG

CODED

C. I. SWITZER WELL CO.

Date: 7/12, 1963, Driller: _____ County: Harrison

(Name)

(1) Owner of Land: Woodstock Beach
(Name)

(Address)

(2) Location: 1/4, 27 10 Sec. 10 T. R
_____ miles _____ of _____
(distance) (direction) (Nearest Town)

(3) Topography: ✓
(Hilly) (Flat) (Level)

(4) Purpose of Well: Commercial
(Domestic Irrigation
Municipal, Industrial, Other)

Description & Color of Materials Sand, Clay, Red Clay, Shell, etc.	Thick- ness Feet	Depth Feet
<u>sand</u>	<u>50</u>	<u>54</u>
<u>clay</u>	<u>57</u>	<u>111</u>
<u>clay & sand str</u>	<u>92</u>	<u>113</u>
<u>clay</u>	<u>113</u>	<u>118</u>
<u>sand</u>	<u>115</u>	<u>123</u>
<u>clay</u>	<u>123</u>	<u>129</u>
<u>sand</u>	<u>129</u>	<u>135</u>
<u>sand w/ clay str</u>	<u>135</u>	<u>156</u>
<u>sand</u>	<u>156</u>	<u>199</u>
<u>clay & sand</u>	<u>199</u>	<u>219</u>
<u>clay</u>	<u>213</u>	<u>264</u>
<u>sand</u>	<u>264</u>	<u>280</u>
<u>clay</u>	<u>280</u>	<u>298</u>
<u>sand</u>	<u>298</u>	<u>324</u>
<u>soft mud</u>	<u>324</u>	<u>338</u>
<u>sand w/ str</u>	<u>339</u>	<u>350</u>
<u>clay</u>	<u>356</u>	<u>387</u>
<u>sand</u>	<u>387</u>	<u>404</u>
<u>sand, fine</u>	<u>404</u>	<u>425</u>
<u>sand</u>	<u>425</u>	<u>431</u>
<u>clay</u>	<u>431</u>	<u>468</u>
<u>sand, fine</u>	<u>468</u>	<u>490</u>
<u>sand w/ str</u>	<u>490</u>	<u>512</u>
<u>sand, fine</u>	<u>512</u>	<u>534</u>
<u>shale w/ sand str</u>	<u>534</u>	<u>579</u>
<u>shale & sand</u>	<u>579</u>	<u>599</u>
<u>shale</u>	<u>599</u>	<u>674</u>
<u>sand, fine</u>	<u>674</u>	<u>731</u>
<u>soft mud</u>	<u>731</u>	<u>775</u>
<u>shale</u>	<u>775</u>	<u>786</u>
<u>sand</u>	<u>786</u>	<u>818</u>
<u>clay</u>	<u>818</u>	<u>850</u>

Information upon completion of well:

(1) Diameter: 12 x 8 inches.

(2) Total Depth: 1054 feet.

(3) Water Level: 6' feet below top of ground.

(4) Cased to: 1054', Size: 12 x 8"


(5) Screen: Size 8", Length 60'

(6) Were any formations sealed against pollution?
✓ yes, _____ no.

If YES depth of formation _____

Why: Health Dept. requirement

Drillers Remarks: _____

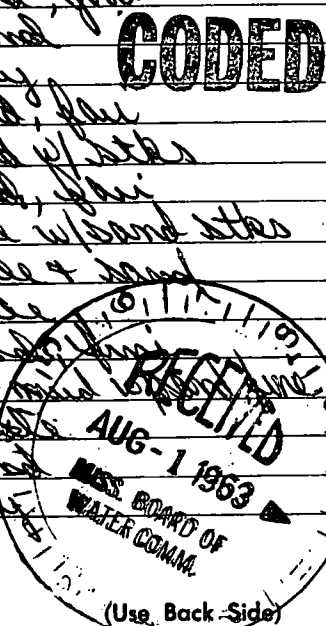

Well No.

