

HAR.
M 461

WATER WELL DRILLERS LOG

CODED

Date: 10-16, 1963, Driller: T. SWITZER WELL CO. County: Adams

10-16-63

(Name)

(1) Owner of Land: James Pearson
(Name)

Edna Kate W. Bilski
(Address)

(2) Location: 31 7 9
_____ $\frac{1}{4}$, _____ $\frac{1}{4}$, Sec. _____ T _____ R _____

_____ miles _____ of _____
(distance) (direction) (Nearest Town)

(3) Topography: _____
(Hilly) (Flat) (Level)

(4) Purpose of Well: Domestic
(Domestic Irrigation
Municipal, Industrial, Other)

Information upon completion of well:

- (1) Diameter 2 inches.
- (2) Total Depth 851 feet.
- (3) Water Level 4' + feet below top of ground.
- (4) Cased to 851', Size 2"
- (5) Screen: Size 2", Length 15'
- (6) Were any formations sealed against pollution?
 yes, _____ no.

If YES depth of formation _____

Why Health Dept. require


Drillers Remarks: _____

Description & Color of Materials
Sand, Clay, Red Clay, Shell, etc.

Thick-
ness
Feet

<u>50-54</u>	<u>clay</u>	
<u>54-60</u>	<u>sand</u>	
<u>60-80</u>	<u>clay & sand sh</u>	
<u>80-100</u>	<u>sand, gravel</u>	
<u>100-110</u>	<u>clay</u>	
<u>110-120</u>	<u>sand, seal fine</u>	
<u>120-140</u>	<u>clay, hard</u>	
<u>140-239</u>	<u>clay</u>	
<u>239-240</u>	<u>sand</u>	
<u>240-258</u>	<u>sand, fine</u>	
<u>258-340</u>	<u>clay</u>	
<u>340-400</u>	<u>clay, hard</u>	
<u>400-412</u>	<u>sand, fine</u>	
<u>412-440</u>	<u>clay</u>	
<u>440-510</u>	<u>clay, hard</u>	
<u>510-530</u>	<u>sand, fine</u>	
<u>530-580</u>	<u>clay</u>	

CODED

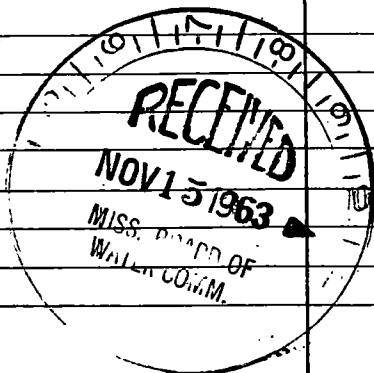

(Use Back Side)

Well No.

1200

[The remainder of the page contains extremely faint and illegible text, likely bleed-through from the reverse side of the document.]