

HAR.
M 463
1-3-64

A 98401
WATER WELL DRILLERS LOG

CODED

Date: 1-3, 19 64, Driller: C. T. SWITZER WELL CO. County: Harrison
(Name)

(1) Owner of Land: Harold J. Davis
(Name)
Highway 4, S. 3rd St. Biloxi
(Address)

(2) Location: 22 7.9
1/4, 7/4, Sec. 7.9 T. R.
miles _____ of _____
(distance) (direction) (Nearest Town)

(3) Topography: (Hilly) (Flat) (Level)

(4) Purpose of Well: Commercial
(Domestic Irrigation, Municipal, Industrial, Other)

Description & Color of Materials Sand, Clay, Red Clay, Shell, etc.	Thick- ness Feet	Depth Feet
Clay	00	20
Sand	20	35
Clay	35	75
Sand	75	95
Clay	95	110
Sand, fine	110	120
Clay	120	145
Sand	145	160
Sand, good	160	165

Information upon completion of well:

(1) Diameter 2 inches.

(2) Total Depth 165' feet.

(3) Water Level 12' feet below top of ground.


(4) Cased to 165', Size 2"

(5) Screen: Size 2", Length 10'

(6) Were any formations sealed against pollution?
 yes, no.

CODED

If YES depth of formation _____
Why Health Dept. requirement
Drillers Remarks: _____

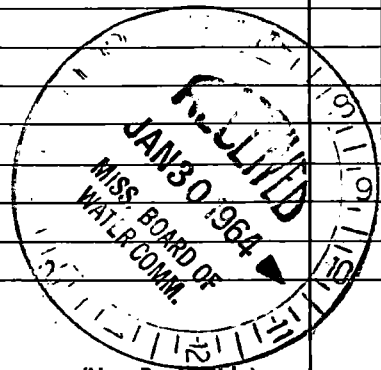

(Use Back Side)

Well No.

Handwritten notes and scribbles at the top of the page, including the word "SOME" and other illegible markings.

Main body of handwritten text, appearing as a list or series of notes, with some lines starting with "11" and "12". The text is extremely faint and mostly illegible due to the quality of the scan.