

HAR.
M 467
7-21-61

M E 483 412

WATER WELL DRILLERS LOG

CODED

Date: July 21, 1961, Driller: C. T. SWITZER WELL CO. County Harrison
(Name)

(1) Owner of Land: Ralph Newman
(Name)
Hillcrest Road
(Address)

(2) Location: 1/4, 1/4, Sec. 19 7 10
1/4 miles SW of
(distance) (direction) (Nearest Town)

(3) Topography: X
(Hilly) (Flat) (Level)

(4) Purpose of Well: Domestic
(Domestic Irrigation
Municipal, Industrial, Other)

Description & Color of Materials Sand, Clay, Red Clay, Shell, etc.	Thick- ness Feet	Depth Feet
<u>clay</u>	<u>0</u>	<u>10</u>
<u>sand</u>	<u>10</u>	<u>22</u>
<u>clay</u>	<u>22</u>	<u>140</u>
<u>sand</u>	<u>140</u>	<u>167</u>
<u>clay</u>	<u>167</u>	<u>188</u>
<u>sand</u>	<u>188</u>	<u>198</u>
<u>clay</u>	<u>198</u>	<u>257</u>
<u>shell</u>	<u>257</u>	<u>293</u>

Information upon completion of well:

(1) Diameter 2" inches.

(2) Total Depth 293' feet.

(3) Water Level 6' feet below top of ground.

(4) Cased to 293', Size 2"

(5) Screen: Size 2" , Length 10'


(6) Were any formations sealed against pollution?
X yes, _____ no.

If YES depth of formation _____

Why Health Dept Requirement

Drillers Remarks: _____

CODED

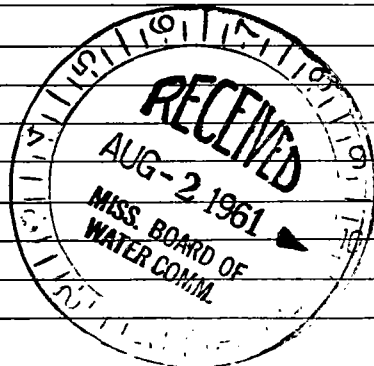

(Use Back Side)

Well No.

no law shall be