

MISSISSIPPI BOARD OF WATER COMMISSIONERS

HARRISON

A 94602

WATER WELL DRILLERS LOG

**CODED**

M 469

7-16-64

Date: 7-16-64, 19\_\_\_, Driller: F. J. SWINNEY WELL CO. County: Jackson

(Name)

(1) Owner of Land: Chester Fountain  
 (Name)  
221 St. Martin Rd Natch Biloxi  
 (Address)  
 (2) Location: 21 79  
 \_\_\_ 1/4, \_\_\_ 1/4, Sec. \_\_\_ T. R. \_\_\_  
 \_\_\_ miles \_\_\_ of \_\_\_  
 (distance) (direction) (Nearest Town)  
 (3) Topography:  (Level)  
 (Hilly) (Flat) (Level)  
 (4) Purpose of Well: Domestic  
 (Domestic Irrigation  
 Municipal, Industrial, Other)


Description & Color of Materials Sand, Clay, Red Clay, Shell, etc.	Thick- ness Feet	Depth Feet
Clay	00	35
Sand	35	40
Sand, good	40	60
Sand w/clay sths	60	80
Sand, good	80	100
Clay	100	120
Sand	120	135
Clay	135	240
Sand	240	260
Sand, extra good	260	290

Information upon completion of well:

(1) Diameter 2 inches.  
 (2) Total Depth 290 feet.  
 (3) Water Level 10' 9" feet below top of ground.  
 (4) Cased to 290', Size 2"  
 (5) Screen: Size 2", Length 10'  
 (6) Were any formations sealed against pollution?  
X yes, \_\_\_ no.

If YES depth of formation \_\_\_\_\_  
 Why Health Dept Requirements  
 Drillers Remarks: \_\_\_\_\_

**CODED**

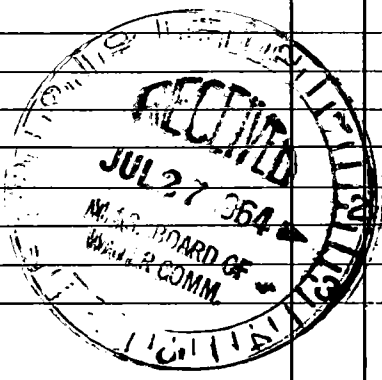

(Use Back Side)

Well No.

