

MISSISSIPPI BOARD OF WATER COMMISSIONERS

HAR.
M470
8-4-64

W 103 506
WATER WELL DRILLERS LOG

CODED *Hamilton*

Date: 8-4-64, 19___, Driller: C. T. SWITZER County: Hamilton
(Name)

(1) Owner of Land: James Fitzgould
(Name)
Gay Road N. Belzoni
(Address)
(2) Location: 8 7 9
S T R
_____ miles _____ of _____
(distance) (direction) (Nearest Town)
(3) Topography: ✓
(Hilly) (Flat) (Level)
(4) Purpose of Well: Domestic
(Domestic Irrigation
Municipal, Industrial, Other)

Description & Color of Materials Sand, Clay, Red Clay, Shell, etc.	Thick- ness Feet	Depth Feet
Clay	20	31
Sand	31	42
Sand & fine gravel	42	63
Clay	63	189
Clay, hard	189	210
Clay	210	252
Clay & fine sand silt	252	273
Clay	273	315
Sand, good	315	348

Information upon completion of well:

(1) Diameter 2 3/8 inches.
841 of 3"

(2) Total Depth 348' feet.

(3) Water Level 21' feet below top of ground.


(4) Cased to 348', Size _____

(5) Screen: Size 10 ga, Length 5510'

(6) Were any formations sealed against pollution?
X yes, _____ no.

CODED

If YES depth of formation _____
Why Health Dept Agreements
Drillers Remarks: _____

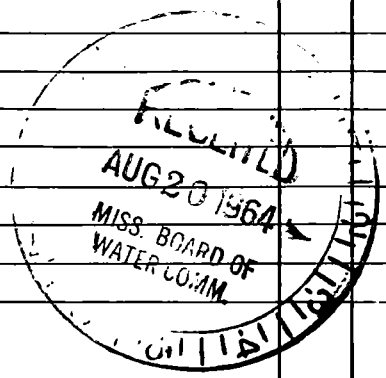

(Use Back Side)

Well No.

0000

0000