

HAR.

M471
10-8-64

WATER WELL DRILLERS LOG

CODED

Date: 10-8, 1964, Driller: C. T. SWITZER WELL CO County: HANDSHAW

(Name)

(1) Owner of Land: Walter Taylor
(Name)
One Fifth Ave., Handshaw
(Address)

(2) Location: 1/4, 1/4, Sec. T. R.
6 7 10
miles (distance), of (direction), of (Nearest Town)

(3) Topography: (Hilly) (Flat) (Level)

(4) Purpose of Well: Commercial
(Domestic, Irrigation, Municipal, Industrial, Other)


Information upon completion of well:

(1) Diameter 4 1/2 inches.
(2) Total Depth 695 feet.
(3) Water Level 14 1/2' feet below top of ground.
(4) Cased to 695', Size 4x3"
(5) Screen: Size 3", Length 20'
(6) Were any formations sealed against pollution?
 yes, no.

If YES depth of formation _____
Why Health Dept. requirement
Drillers Remarks: _____

Description & Color of Materials Sand, Clay, Red Clay, Shell, etc.	Thick- ness Feet	Depth Feet
sand	10	24
clay	24	44
sand	44	59
clay	59	64
sand	64	79
clay	79	84
sand	84	102
clay	102	129
sand	129	139
clay	139	189
sand	189	204
clay	204	348
shale	348	368
sand shes	368	429
shale + clay	429	449
clay w/ sand shes	449	469
shale	469	489
clay	489	509
sand, fine	509	540
clay	540	550
sand	550	564
clay	564	570
sand	570	644

CODED

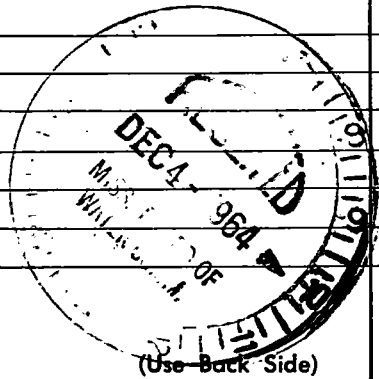

Well No.

0000