

HARRISON
M 471
8-27-72

MISSISSIPPI
 BOARD OF WATER COMMISSIONERS
 416 North State Street
 Jackson, Mississippi 39201

CODED

WATER WELL DRILLERS LOG

8-27 1972 Switzer Well Company Harrison
 date well completed firm name county well located

LANDOWNER: <u>Imperial Estates</u>	description of formations encountered	from	to
<u>Pt 6, Pappas Ferry Rd.</u>			
<u>Biloxi, Miss. 39532</u> (mailing address)	clay	0	6
WELL LOCATION:	sand	6	14
sec. <u>13</u> T. <u>7</u> S. R. <u>10</u> W.	mixed	14	22
<u>2 1/2</u> miles <u>NW</u> of <u>Biloxi</u>	clay	22	70
(distance) (direction) (nearest town)	Shale	70	75
WELL PURPOSE: <u>drinking water</u> (home, irrigation, municipal, industrial)	sand	75	80
WELL COMPLETION DATA:	mixed	80	94
(1) diameter (inches) <u>3"</u>	sand	94	115
(2) total depth (feet) <u>579'</u>	clay	115	160
(3) static water level (feet) <u>-54</u> ^{below} above top of ground.	mixed	160	175
(4) casing <u>galv.</u> <u>579'</u> (material) (depth)	clay	175	239
<u>4"</u> If telescope see back. (size)	clay + sand	239	259
(5) screen <u>40'</u> <u>539'</u> (length) (depth to top)	clay	259	319
<u>008</u> <u>stainless steel</u> (size) (material)	sand sh.	319	339
(6) pump <u>5</u> <u>40</u> (HP) (yield gpm)	good sand	339	379
<u>Electric</u> (type power)	sand	379	381
(7) electric log <u>no</u> (yes or no)	clay	381	418
(organization running log)	mixed	418	438
(8) how well bottom plugged <u>back</u> <u>pressure valve</u>	sand + clay	438	458
DRILLERS REMARKS:	clay	458	478
	sand	478	483
	clay	483	494
	sand	494	579


CODED

SEP 28 1972

with an OF
 record book

If well telescopes please sketch and show depths.

GROUND LEVEL

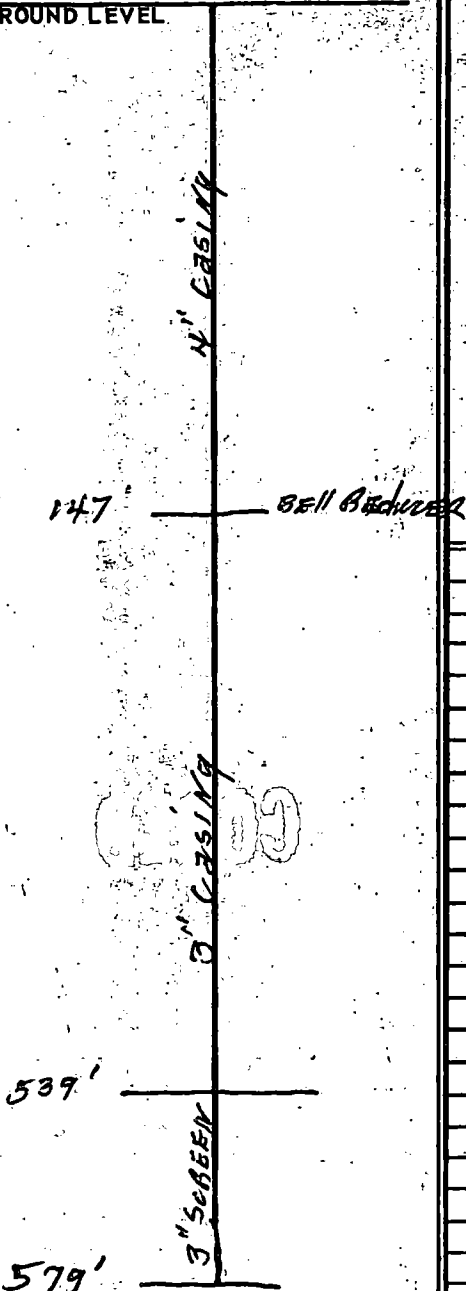

x			

SECTION 13

Please indicate well location X.

ADDITIONAL INFORMATION

If more than one screen, show locations of each on sketch.