

M474

2-23-65

D90439

WATER WELL DRILLERS LOG

CODED

Date: 2-23, 1965, Driller: C. T. Switzer Well & County Harrison
 (Name)

(1) Owner of Land: John W. Atkinson
 (Name)
Atkinson Road Balak Miss
 (Address)
 (2) Location: 23 710
20 10
 1/4, 1/4, Sec T R
 miles of
 (distance) (direction) (Nearest Town)
 (3) Topography: _____
 (Hilly) (Flat) (Level)
 (4) Purpose of Well: Domestic
 (Domestic Irrigation
 Municipal, Industrial, Other)

Description & Color of Materials Sand, Clay, Red Clay, Shell, etc.	Thick- ness Feet	Depth Feet
<u>Sand</u>	<u>0</u>	<u>21</u>
<u>Clay</u>	<u>21</u>	<u>42</u>
<u>Sand</u>	<u>42</u>	<u>57</u>
<u>Clay</u>	<u>57</u>	<u>121</u>
<u>Sand</u>	<u>121</u>	<u>126</u>
<u>Sand + clay streaks</u>	<u>126</u>	<u>147</u>
<u>Sand</u>	<u>147</u>	<u>163</u>
<u>Clay</u>	<u>163</u>	<u>168</u>
<u>Sand, fine</u>	<u>168</u>	<u>198</u>

Information upon completion of well:


(1) Diameter 3x2 inches.
84' 3"
 (2) Total Depth 198 feet.
 (3) Water Level 17' 8" feet below top of ground.
 (4) Cased to 198, Size 3x2
 (5) Screen: Size 2", Length 15' 8 1/2"
 (6) Were any formations sealed against pollution?
X yes, _____ no.

If YES depth of formation _____

Why Health Dept. Request

Drillers Remarks: _____

CODED

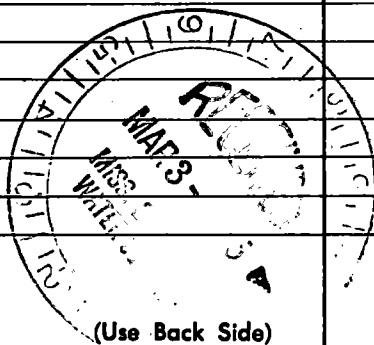

Well No.

1950

1950