

M 475
7-21-65

WATER WELL DRILLERS LOG

CODED

A 104613

Date: 7-21-65, 19___, Driller: C. T. Bentley Well Co County Harrison
(Name)

(1) Owner of Land: Ralph Daig Jr
(Name)
Big Ridge Rd N Belok Miss
(Address)
(2) Location: ___ 1/4, ___ 1/4, Sec. ___ T. R. ___
9 7 9
miles of
(distance) (direction) (Nearest Town)
(3) Topography: X
(Hilly) (Flat) (Level)
(4) Purpose of Well: domestic
(Domestic Irrigation
Municipal, Industrial, Other)


Description & Color of Materials Sand, Clay, Red Clay, Shell, etc.	Thick- ness Feet	Depth Feet
Clay	0	21
Sand + few gravel	21	42
Sand	42	48
Clay	48	72
Sand	72	81
Sand + few clay stones	81	101
Sand	101	105
Clay	105	147
Sand	147	171
Clay, real fine	171	181
Clay	181	277
Sand fine	277	300

Information upon completion of well:

(1) Diameter 2" inches.
(2) Total Depth 300 feet.
(3) Water Level 35 - feet below top of ground.
(4) Cased to 300, Size 2"
(5) Screen: Size 2", Length 10' 8"
(6) Were any formations sealed against pollution?
X yes, ___ no.

If YES depth of formation _____
Why _____

Drillers Remarks: Health Dept
Permits

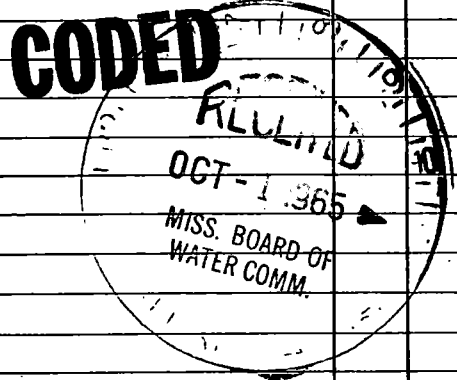

(Use Back Side)

Well No.

1900

1. 1st of Jan. 1900
 2. 1st of Feb. 1900
 3. 1st of March 1900
 4. 1st of April 1900
 5. 1st of May 1900
 6. 1st of June 1900
 7. 1st of July 1900
 8. 1st of Aug. 1900
 9. 1st of Sept. 1900
 10. 1st of Oct. 1900
 11. 1st of Nov. 1900
 12. 1st of Dec. 1900

13. 1st of Jan. 1901
 14. 1st of Feb. 1901
 15. 1st of March 1901
 16. 1st of April 1901
 17. 1st of May 1901
 18. 1st of June 1901
 19. 1st of July 1901
 20. 1st of Aug. 1901
 21. 1st of Sept. 1901
 22. 1st of Oct. 1901
 23. 1st of Nov. 1901
 24. 1st of Dec. 1901