

M476
9-11-65

WATER WELL DRILLERS LOG

CODED

T 171 334

Date: 9-11-65, 19___, Driller: C. T. Lutzger Well Co. County Harrison
(Name)

(1) Owner of Land: Miss Annie B. Patrick
(Name)
1808 Pass Road
Handabara Miss
(Address) 29710

(2) Location: ___ 1/4, ___ 1/4, Sec. T R,
_____ miles _____ of _____
(distance) (direction) (Nearest Town)

(3) Topography: X
(Hilly) (Flat) (Level)

(4) Purpose of Well: Domestic
(Domestic Irrigation
Municipal, Industrial, Other)

Description & Color of Materials Sand, Clay, Red Clay, Shell, etc.	Thick- ness Feet	Depth Feet
<u>Sand</u>	<u>0</u>	<u>22</u>
<u>Clay</u>	<u>22</u>	<u>55</u>
<u>Sand</u>	<u>55</u>	<u>92</u>
<u>Clay</u>	<u>92</u>	<u>162</u>
<u>Sand + clay streaks</u>	<u>162</u>	<u>182</u>
<u>Sand</u>	<u>182</u>	<u>190</u>
<u>Clay</u>	<u>190</u>	<u>210</u>
<u>Sand, fine</u>	<u>210</u>	<u>262</u>
<u>Sand</u>	<u>262</u>	<u>265</u>
<u>Clay</u>	<u>265</u>	<u>268</u>
<u>Sand</u>	<u>268</u>	<u>282</u>
<u>Sand, good</u>	<u>282</u>	<u>301</u>

Information upon completion of well:

(1) Diameter 2 1/2 inches.

(2) Total Depth 301 feet.

(3) Water Level 22' feet below top of ground.
top 84'-3"

(4) Cased to 301, Size 2 1/2"

(5) Screen: Size 8 ga 2", Length 15 ft.



(6) Were any formations sealed against pollution?
X yes, ___ no.

If YES depth of formation _____

Why Health Dept. Agreement

Drillers Remarks: _____

CODED

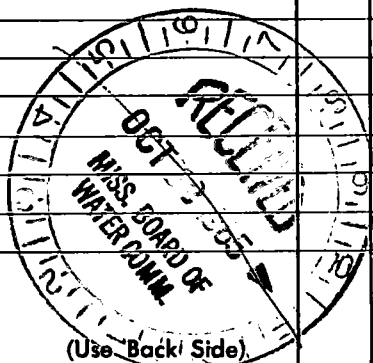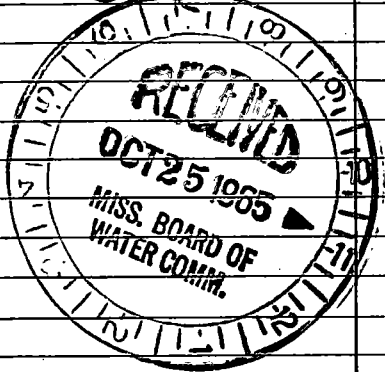

Well No. _____

1911

Faint, illegible text covering the majority of the page, possibly bleed-through from the reverse side.