

HAR.

MISSISSIPPI BOARD OF WATER COMMISSIONERS

M 477  
4-5-66

A 94612

WATER WELL DRILLERS LOG

CODED

Date: 4-5-66, 19\_\_\_, Driller: C. T. Burtzwell Co. County Harrison  
(Name)

(1) Owner of Land: Andrew Loustain  
(Name)  
Gulf Stream St. N. Bilal  
off Race Lark Road  
(Address)

(2) Location: 1/4, 1/4, Sec 21 T. R.  
miles, of  
(distance) (direction) (Nearest Town)

(3) Topography: flat  
(Hilly) (Flat) (Level)

(4) Purpose of Well: domestic  
(Domestic Irrigation  
Municipal, Industrial, Other)

| Description & Color of Materials<br>Sand, Clay, Red Clay, Shell, etc. | Thick-<br>ness<br>Feet | Depth<br>Feet |
|---|------------------------|---------------|
| Clay  | 0                      | 21            |
| Sand  | 20                     | 41            |
| Clay  | 41                     | 61            |
| Sand + clay sika  | 61                     | 81            |
| Clay  | 81                     | 121           |
| Sand  | 121                    | 136           |
| Clay  | 131                    | 181           |
| Sand  | 181                    | 196           |
| Clay  | 196                    | 201           |
| Clay + sand sika  | 201                    | 221           |
| Sand, fair  | 221                    | 241           |
| Sand  | 241                    | 246           |
| Clay  | 246                    | 261           |
| Sand, good  | 261                    | 301           |

Information upon completion of well:


- (1) Diameter 2 inches.
- (2) Total Depth 301 feet.
- (3) Water Level 12' - feet below top of ground.
- (4) Cased to 301, Size 2"
- (5) Screen: Size Egg 66, Length 10'
- (6) Were any formations sealed against pollution?  
X yes, no.

If YES depth of formation

Why Health Dept. Agreement

Drillers Remarks:

CODED

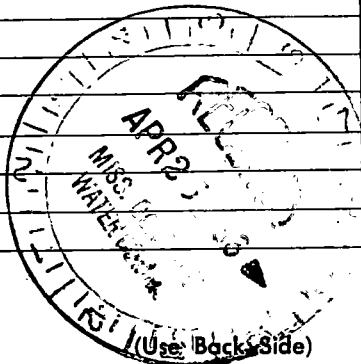

Well No.

03003

12/15  
12/16  
12/17  
12/18  
12/19  
12/20  
12/21  
12/22  
12/23  
12/24  
12/25  
12/26  
12/27  
12/28  
12/29  
12/30  
12/31

12/15  
12/16  
12/17  
12/18  
12/19  
12/20  
12/21  
12/22  
12/23  
12/24  
12/25  
12/26  
12/27  
12/28  
12/29  
12/30  
12/31

12/15  
12/16  
12/17  
12/18  
12/19  
12/20  
12/21  
12/22  
12/23  
12/24  
12/25  
12/26  
12/27  
12/28  
12/29  
12/30  
12/31

103

104

105

106

107

108

109

110

111

112

113

114