

HAR.

MISSISSIPPI BOARD OF WATER COMMISSIONERS

M478

A 96308

CODED

4-7-66

WATER WELL DRILLERS LOG

Date: 4-7-66, 19, Driller: C.T. Surtzger Well Co County Harrison (Name)

(1) Owner of Land: Henry N Fowler
(Name)

113 Duane Rd N Belz
(Address)

(2) Location: 22 79
1/4, 1/4, Sec. 7 R

7 miles, of
(distance) (direction) (Nearest Town)

(3) Topography: Flat
(Hilly) (Flat) (Level)

(4) Purpose of Well: domestic
(Domestic Irrigation, Municipal, Industrial, Other)

Description & Color of Materials Sand, Clay, Red Clay, Shell, etc.	Thick- ness Feet	Depth Feet
Clay	0	41
Clay + sand streaks	41	81
Sand	81	106
Clay	106	116
Sand	116	141
Clay + sand streaks	141	161
Sand	161	171
Clay	171	201
Clay, Sand	201	261
Sand, fair	261	273
Clay	273	281
Clay, red sand	281	301
Clay + sand streaks	301	321
Clay	321	329
Sand	329	370

Information upon completion of well:

(1) Diameter 2x3 inches.

(2) Total Depth 370 feet.

(3) Water Level 14' - feet below top of ground. 63' - 3"

(4) Cased to 370, Size 2" x 3"

(5) Screen: Size 8ga, Length 10' 6x


(6) Were any formations sealed against pollution?
X yes, no.

CODED

If YES depth of formation _____

Why Health Dept Request

Drillers Remarks: _____

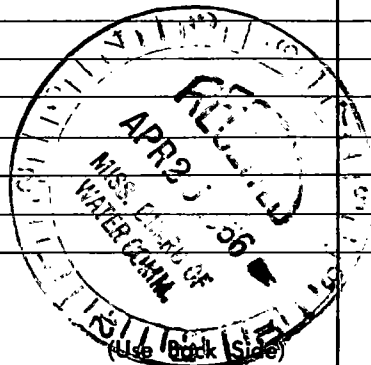

Well No. _____

