

HAR. MISSISSIPPI BOARD OF WATER COMMISSIONERS

M479

5-25-66

WATER WELL DRILLERS LOG

CODED

Date: 5-25-66, 1966, Driller: C.T. Switzer Well Co. County Harrison
(Name)

(1) Owner of Land: Southwind Motel
(Name)

W. Beach Biloxi, Highway 90
(Address)

(2) Location: 1/4, 1/4, Sec. 35 7, 10 T. R.

 miles of
(distance) (direction) (Nearest Town)

(3) Topography: X
(Hilly) (Flat) (Level)

(4) Purpose of Well: domestic
(Domestic Irrigation
Municipal, Industrial, Other)

Description & Color of Materials Sand, Clay, Red Clay, Shell, etc.	Thick- ness Feet	Depth Feet
sand	0	32
soft clay	32	45
mixed	45	66
soft clay	66	87
clay	87	134
sand	134	142
clay	142	155
sand	155	164
clay	164	175
mixed	175	204
sand fine	204	225
clay	225	561
clay & shale	561	584
shale	584	586
sand good	586	648
sand extra good	648	690

Information upon completion of well:

(1) Diameter 2 x 3 inches.

(2) Total Depth 690 feet.


(3) Water Level 11' feet below top of ground.
top 100' - 4"

(4) Cased to 690', Size 2 x 3"

(5) Screen: Size 8 gass, Length 42'

(6) Were any formations sealed against pollution?
X yes, no.

CODED

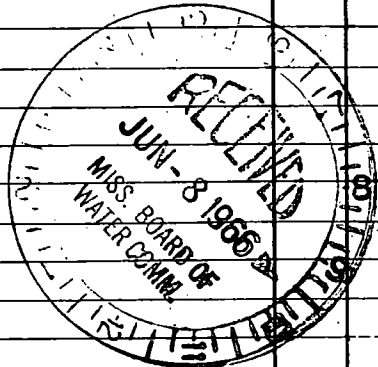

If YES depth of formation

Why Health Dept. Reagents.

Drillers Remarks:

(Use Back Side)

Well No.

00000