

HAR.

M480

7-2-66

MISSISSIPPI BOARD OF WATER COMMISSIONERS

A 95901

WATER WELL DRILLERS LOG

CODED

Date: 7-2-66, 1966, Driller: C.T. Switzer, Well Co. County Harrison

(When well drilled)

(Name)

(Where well is located)

(1) Owner of Land: Arthur Beaughey  
(Name)  
125 Quave Rd., N. Biloxi, Miss.  
(Address)

(2) Location: 1/4, 1/4, Sec 27 T7R9.  
\_\_\_\_\_ miles \_\_\_\_\_ of \_\_\_\_\_  
(distance) (direction) (Nearest Town)

(3) Topography: X  
(Hilly) (Flat) (Level)

(4) Purpose of Well: domestic  
(Domestic Irrigation  
Municipal, Industrial, Other)

| Description & Color of Materials<br>Sand, Clay, Red Clay, Shell, etc. | Thick-<br>ness<br>Feet | Depth<br>Feet |
|-----------------------------------------------------------------------|------------------------|---------------|
| clay                                                                  | 0                      | 21            |
| sand                                                                  | 21                     | 31            |
| clay                                                                  | 31                     | 67            |
| sand                                                                  | 67                     | 107           |
| clay                                                                  | 107                    | 122           |
| sand                                                                  | 122                    | 142           |
| clay                                                                  | 142                    | 162           |
| mixed                                                                 | 162                    | 182           |
| clay                                                                  | 182                    | 257           |
| good sand                                                             | 257                    | 262           |
| real good sand                                                        | 262                    | 282           |
| good sand                                                             | 282                    | 288           |
| clay                                                                  | 288                    | 322           |
| good sand                                                             | 322                    | 363           |
| sand                                                                  | 363                    | 367           |

Information upon completion of well:

(1) Diameter 2 inches.

(2) Total Depth 367 feet.


(3) Water Level 17' feet below top of ground.

(4) Cased to 367', Size 2"

(5) Screen: Size 8ga 55, Length 10'

(6) Were any formations sealed against pollution?  
X yes, \_\_\_\_\_ no.

CODED

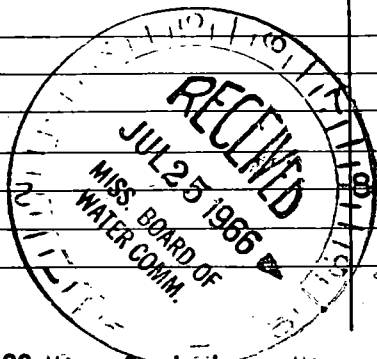

If YES depth of formation \_\_\_\_\_


Why Health Dept. Permits.

Drillers Remarks: \_\_\_\_\_

Yield in gpm: \_\_\_\_\_

Size pump: \_\_\_\_\_

Type power: \_\_\_\_\_

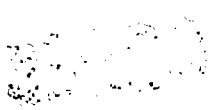

1  
 2  
 100