

HAR.

MISSISSIPPI BOARD OF WATER COMMISSIONERS

M 482

WATER WELL DRILLERS LOG

CODED

8-21-62

C. T. SWITZER WELL CO.

Date: 8-21, 1962, Driller: County Harrison

(Name)

(1) Owner of Land: Paulah Sumrell

(Name)

Rossine Rd, Yonkers

(Address)

(2) Location: 1/4, 1/4, Sec. 7, T. R.

miles of (distance) (direction) (Nearest Town)

(3) Topography: (Hilly) (Flat) (Level)

(4) Purpose of Well: Domestic (Domestic Irrigation, Municipal, Industrial, Other)

Description & Color of Materials Sand, Clay, Red Clay, Shell, etc.	Thick- ness Feet	Depth Feet
Clay	00	40
Sand, good	40	60
Clay	60	75
Gravel	75	80
Sand & Gravel	80	100
Clay	100	140
Sand, good	140	180
Clay & few sand str.	180	200
Clay	200	235
Sand	235	260
Sand, good	260	280

Information upon completion of well:

- (1) Diameter 2 inches.
- (2) Total Depth 280 feet.
- (3) Water Level 11' feet below top of ground.
- (4) Cased to 280', Size 2"
- (5) Screen: Size 2", Length 10'
- (6) Were any formations sealed against pollution?


yes, no.

If YES depth of formation

Why Health Dept. Requirement

Drillers Remarks:

CODED

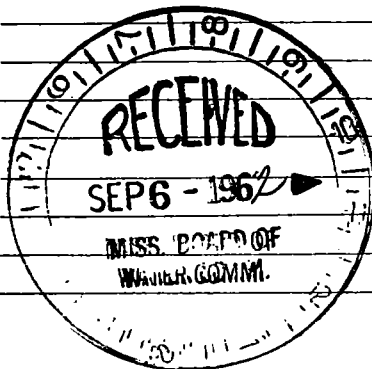

(Use Back Side)

Well No.

