

HAR.  
M483  
11-11-63

WATER WELL DRILLERS LOG

**CODED**

U. 398007

Date: 11-11, 1963 Driller: C. T. SWITZER WELL CO. County: Woodain

(Name)

(1) Owner of Land: 1st National Bank  
(Name)

E. Pasch Lot, near Edgewater  
(Address)

(2) Location: 345 710  
\_\_\_\_\_ miles \_\_\_\_\_ of \_\_\_\_\_  
(distance) (direction) (Nearest Town)

(3) Topography: \_\_\_\_\_  
(Hilly) (Flat) (Level)

(4) Purpose of Well: Commercial  
(Domestic Irrigation  
Municipal, Industrial, Other)

Description & Color of Materials  
Sand, Clay, Red Clay, Shell, etc.

Thick-  
ness  
Feet

|                            |  |
|----------------------------|--|
| 39-39 sand                 |  |
| 39-56 clay                 |  |
| 56-70 sand                 |  |
| 70-119 clay                |  |
| 119-131 sand               |  |
| 131-144 clay               |  |
| 144-219 sand, fine         |  |
| 219-225 clay               |  |
| 225-245 clay w/ sand shls  |  |
| 245-265 soft mud           |  |
| 265-285 clay               |  |
| 285-303 sand               |  |
| 303-306 clay               |  |
| 306-328 sand w/ mud shls   |  |
| 328-348 clay w/ shls       |  |
| 348-363 sand               |  |
| 363-428 clay               |  |
| 428-508 shale              |  |
| 508-529 shale w/ fine sand |  |
| 529-588 shale              |  |
| 588-589 sand               |  |
| 589-644, sand, gravel      |  |

Information upon completion of well:

(1) Diameter 3x4 inches.

(2) Total Depth 644 feet.

(3) Water Level 14' - feet below top of ground.

(4) Cased to 644', Size 3x4"

(5) Screen: Size 3", Length 20'


(6) Were any formations sealed against pollution?  
✓ yes, \_\_\_\_\_ no.

If YES depth of formation \_\_\_\_\_

Why Health Dept. Requirement

Drillers Remarks: \_\_\_\_\_

**CODED**

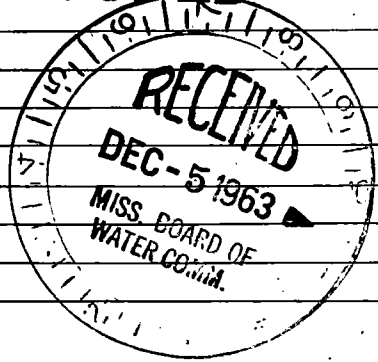

(Use Back Side)

