

HAR.

MISSISSIPPI BOARD OF WATER COMMISSIONERS

M 484

Q 216 308

11-4-65

WATER WELL DRILLERS LOG

CODED

Date: 11-4-65, 19___, Driller: C. T. Burtzger Well Co County Harrison
(Name)

(1) Owner of Land: James F. Snell
(Name)
Corner of Magnolia & Pine
St. Mark's
(Address)

(2) Location: 1/4, 1/4, Sec. 30710
SW Dr
(distance) (direction) of (Nearest Town)

(3) Topography: X
(Hilly) (Flat) (Level)

(4) Purpose of Well: domestic
(Domestic Irrigation
Municipal, Industrial, Other)

Description & Color of Materials Sand, Clay, Red Clay, Shell, etc.	Thick- ness Feet	Depth Feet
Sand	0	21
Clay	21	42
Sand	42	44
Sand & gravel	44	58
Mixed	58	65
Mixed sand, clay & gravel	65	87
Clay & gravel	87	95
Clay	95	176
Sand, medium good	176	190
Clay	190	192
Clay & sand silt	192	214
Sand, fine & clay silt	214	236
Sand, medium	236	279
Sand, good	279	309
Clay	309	361
Sand, good	361	402

Information upon completion of well:

Sp 105 311

(1) Diameter 2x3 inches.

(2) Total Depth 402 feet.


(3) Water Level 21' feet below top of ground.

(4) Cased to 402, Size 2x3

(5) Screen: Size 20' 10ga Length 20'

(6) Were any formations sealed against pollution?
X yes, ___ no.

CODED

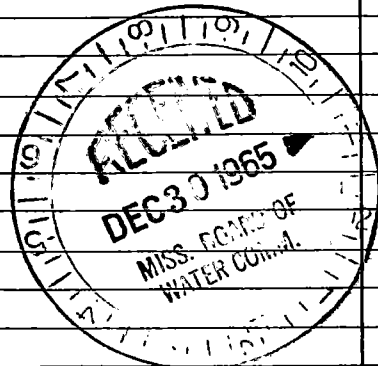

If YES depth of formation _____

Why Health Dept Request

Drillers Remarks: _____

(Use Back Side)

Well No.

70

1950

1950