

HAR.

MISSISSIPPI BOARD OF WATER COMMISSIONERS

AM 485

12-17-65

WATER WELL DRILLERS LOG

CODED

Date: 12-17-65, 19___, Driller: C. T. Surtzwell Co County Harrison

(Name)

TOMLINSON

(1) Owner of Land: Dr John H Tomlinson

(Name)

Lorraine Rd Sulfate

(Address)

(2) Location: 1/4, 1/4, Sec. T R

19 7 10

miles (distance), of (direction), of (Nearest Town)

(3) Topography: X

(Hilly) (Flat) (Level)

(4) Purpose of Well: domestic

(Domestic Irrigation, Municipal, Industrial, Other)

Description & Color of Materials
Sand, Clay, Red Clay, Shell, etc.

Thick-
ness
Feet

Depth
Feet

Clay	0	20
Clay + sand strata	20	40
Sand	40	55
Clay	55	100
Sand	100	115
Clay	115	135
Sand	135	162
Clay	162	180
Clay + sand strata	180	200
Clay	200	252
Sand	252	282

Information upon completion of well:

(1) Diameter 2" inches.

(2) Total Depth 282 feet.

(3) Water Level 12'6" feet below top of ground.

(4) Cased to 282', Size

(5) Screen: Size 8gals, Length 10'

(6) Were any formations sealed against pollution?


X yes, no.

If YES depth of formation

Why Health Dept Agreements

Drillers Remarks:

CODED

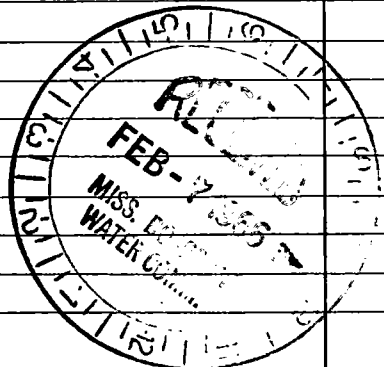

(Use Back Side)

Well No.

