

Harrison
M486
10-67

MISSISSIPPI
BOARD OF WATER COMMISSIONERS
416 North State Street
Jackson, Mississippi 39201

CODED

WATER WELL DRILLERS LOG

10-23 1967 Sutter Well Works Harrison
date well completed firm name county well located

LANDOWNERS: Southern Shell Fish Co.

description of formations encountered	from	to
shells	0	15
Clay & shells	15	135
sand	135	155
clay	155	343
sand	343	372
clay	372	585
sand	585	670
clay	670	806
sand	806	888
clay	888	1053
sand	1053	1119
clay	1119	1122
sand	1122	1159

Bilphi Miss.
(mailing address)


WELL LOCATION:
sec. 28 T. 7 N. R. 9 E. S. 5 W.
miles 1.1 IN of Bilphi
(distance) (direction) (nearest town)

WELL PURPOSE: Industrial
(home, irrigation, municipal, industrial)

WELL COMPLETION DATA:

- (1) diameter (inches) 6
- (2) total depth (feet) 1159
- (3) static water level (feet) 16 ^{below} above top of ground.
- (4) casing sch. steel (material), 45' (depth), 6" ^{top} (size) if telescope see back.
- (5) screen 40' (length), see back (depth to top), 6" (size), stainless steel (material)
- (6) pump none (HP), (yield gpm) (type power)
- (7) electric log no (yes or no) (organization running log)
- (8) how well bottom plugged B.P. Value

CODED

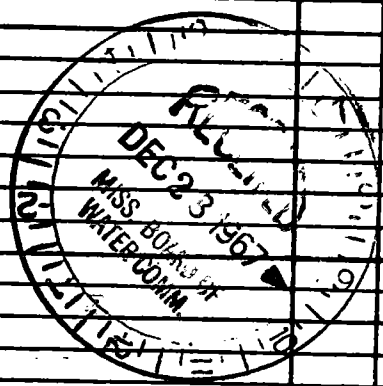

DRILLERS REMARKS:

If well telescopes please sketch and show depths.

GROUND LEVEL


45' of 6" galv. pipe

1054' of 6" blk pipe

6" x 20' SS Strun

20' of 6" blk. pipe

6" x 20' SS Strun

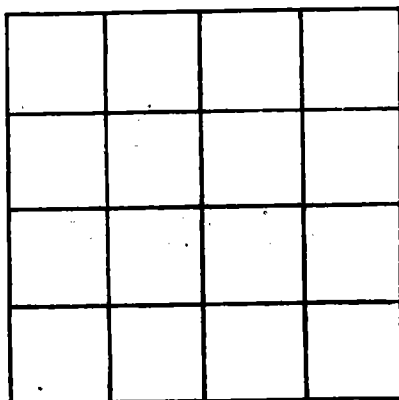

SECTION _____

Please indicate well location X.

ADDITIONAL INFORMATION

If more than one screen, show locations of each on sketch.