

HARRISON  
M 487  
3-22-71

MISSISSIPPI  
 BOARD OF WATER COMMISSIONERS  
 416 North State Street  
 Jackson, Mississippi 39201  
 WATER WELL DRILLERS LOG

**CODED**

MARCH 22 1971 C.T. Switzer Well Co. HARRISON  
 date well completed firm name county well located

LANDOWNER: Bester C. Thorn  
Rt. 5 Box 150  
Gulfport, Miss. 39501  
 (mailing address)

WELL LOCATION:  
 sec. 19 T. 7 S. R. 10 W.  
1 1/4 miles N of HANDS BORO  
 (distance) (direction) (nearest town)

WELL PURPOSE: HOME  
 (home, irrigation, municipal, industrial)

WELL COMPLETION DATA:

(1) diameter (inches) 2"

(2) total depth (feet) 291'

(3) static water level (feet) 14' 10" <sup>below</sup> above top of ground.

(4) casing ALV. 291'  
 (material) (depth)  
       if telescope see back.  
 (size)

(5) screen 10' 281'  
 (length) (depth to top)  
008 stainless steel  
 (size) (material)

(6) pump 1/2 6  
 (HP) (yield gpm)  
ELECTRIC  
 (type power)

(7) electric log NO  
 (yes or no)  
        
 (organization running log)

(8) how well bottom plugged back  
pressure valve

description of formations encountered	from	to
SAND	0	10
CLAY	10	21
MIXED	21	41
CLAY	41	81
SAND	81	91
CLAY	91	140
MIXED	140	150
CLAY	150	259
SAND	259	291

**CODED**


APR - 9 1971

MISS. BD. OF  
 WATER CONTROL

DRILLERS REMARKS:

If well telescopes please sketch and show depths.

GROUND LEVEL

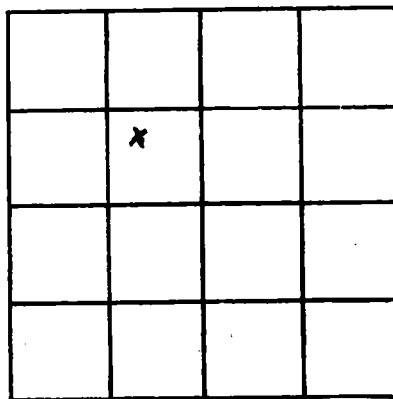

SECTION 19

Please indicate well location X.

ADDITIONAL INFORMATION

If more than one screen, show locations of each on sketch.