

HARRISON
M 489
3-25-71

MISSISSIPPI
 BOARD OF WATER COMMISSIONERS
 416 North State Street
 Jackson, Mississippi 39201
 WATER WELL DRILLERS LOG

CODED

3-25 1971 C.T. Switzer Well Co HARRISON
 date well completed firm name county well located

LANDOWNER: ALBERT WETZEL
Rt. 2 Brasher Road
Biloxi, Miss. 39632
 (mailing address)
 WELL LOCATION:
 sec 24 T 7 S R 12
2 1/4 miles NW of Biloxi
 (distance) (direction) (nearest town)

description of formations encountered	from	to
CLAY	0	15
SAND	15	20
CLAY	20	60
SAND	60	75
CLAY	75	80
MIXED	80	100
CLAY	100	222
SAND	222	232
CLAY	232	277
SAND, fair	277	292
CLAY	292	347
SAND, fair	347	367
SAND, good	367	398

WELL PURPOSE: HOME
 (home, irrigation, municipal, industrial)

WELL COMPLETION DATA:
 (1) diameter (inches) 2"
 (2) total depth (feet) 398'
 (3) static water level (feet) 17'03" ^{below} top of ground
 (4) casing galv. 398'
 (material) (depth)
2 1/2" If telescope see back.
 (size)
 (5) screen 10' 388'
 (length) (depth to top)
008 stainless steel
 (size) (material)
 (6) pump 1/2 6
 (HP) (yield gpm)
ELECTRIC
 (type power)
 (7) electric log No
 (yes or no)
 (organization running log)
 (8) how well bottom plugged back
pressure valve

DRILLERS REMARKS:


CODED

APR 9 1971

MISS. BD. OF
 WATER COMM.

If well telescopes please sketch and show depths.

GROUND LEVEL

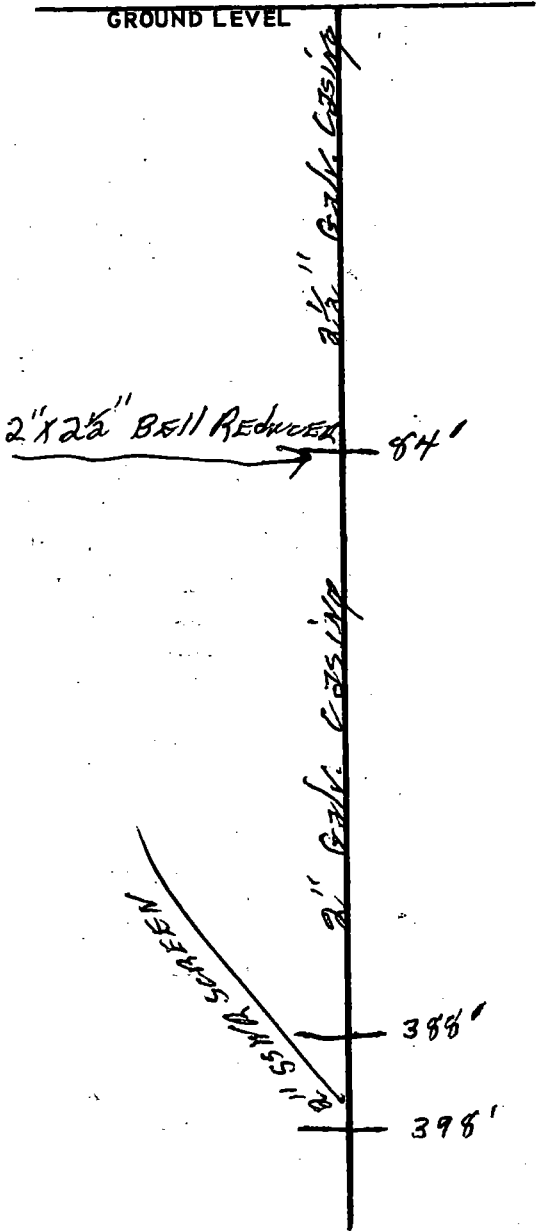

	X		

SECTION 24

Please indicate well location X.

ADDITIONAL INFORMATION

If more than one screen, show locations of each on sketch.