

HARRISON
M490
3-26-71

MISSISSIPPI
BOARD OF WATER COMMISSIONERS
416 North State Street
Jackson, Mississippi 39201
WATER WELL DRILLERS LOG

CODED

3-26 1971 Switzer Well Co. HARRISON
date well completed firm name county well located

LANDOWNER Gerald J. Diaz

405 Boney Ave.

Biloxi, Miss. 39531
(mailing address)

WELL LOCATION:

sec. 7 T. 7 S. R. 9 W. 1/8 1/4 1/4
2 miles NW of Biloxi
(distance) (direction) (nearest town)

WELL PURPOSE: HOME
(home, irrigation, municipal, industrial)

WELL COMPLETION DATA:

(1) diameter (Inches) 2"
(2) total depth (feet) 368'
(3) static water level (feet) 41' ^{below} above
top of ground.

(4) casing 9ALV. 368'
(material) (depth)

 If telescope see back.
(size)

(5) screen 10' 358'
(length) (depth to top)

008 Stainless steel
(size) (material)

(6) pump 1 11
(HP) (yield gpm)

ELECTRIC
(type power)

(7) electric log NO
(yes or no)

(organization running log)

(8) how well bottom plugged back
pressure valve

DRILLERS REMARKS:

description of formations
encountered

from to

CLAY	0	10
Mixed	10	21
CLAY	21	40
SAND	40	55
SAND with clay	55	60
CLAY	60	120
SAND	120	130
MIXED	130	140
CLAY	140	150
Sand, fine	150	160
Sand, fair	160	179
CLAY	179	214
SAND	214	236
CLAY	236	326
SAND, good	326	368

CODED


APR - 9 1971

MISS. BD. OF
WATER COMM.

MISS. BD. OF
WATER COMM.

If well telescopes please sketch and show depths.

GROUND LEVEL

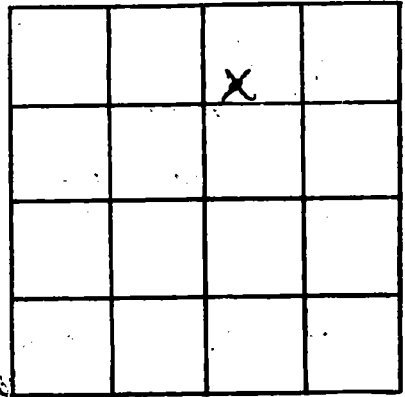

SECTION 7

Please indicate well location X.

ADDITIONAL INFORMATION

If more than one screen, show locations of each on sketch.