

HAR.
M 491
11-12-63

5 168 313

WATER WELL DRILLERS LOG

CODED

Date: 11-12, 1963, Driller: C. T. SWITZER WELL CO. County: Norfolk

(Name)

(1) Owner of Land: Miss Central Refining
(Name)
C. Howard Ave, Biloxi
(Address)

(2) Location: 1/4, 1/4, Sec. 34 T 79 R 9
miles 0.5 of PP (Nearest Town)
(distance) (direction)

(3) Topography: (Hilly) (Flat) (Level)

(4) Purpose of Well: Commercial
(Domestic Irrigation, Municipal, Industrial, Other)

Description & Color of Materials Sand, Clay, Red Clay, Shell, etc.	Thick- ness Feet	Depth Feet
Sand	00	21
clay	21	58
Sand	58	64
clay	64	74
Sand	74	133
clay	133	173
Sand	173	185
clay	185	227
clay & sand str	227	242
clay	242	302
Sand	302	306
clay	306	342
Sand	342	362
clay	362	449
Sand str & clay	449	469
clay	469	518
Sand	518	530
clay	530	590
clay w/ rocks	590	610
clay	610	631
Sand	631	670
clay	670	678
Sand	678	686
clay	686	783
Sand	783	790
clay	790	839
Sand	839	914

CODED

Information upon completion of well:

(1) Diameter 6x4 inches.

(2) Total Depth 945 feet.

(3) Water Level 10' feet below top of ground.

(4) Cased to 945', Size 6x4"


(5) Screen: Size 4", Length 50'

(6) Were any formations sealed against pollution?
 yes, no.

If YES depth of formation _____

Why Health Dept. requirement

Drillers Remarks: _____

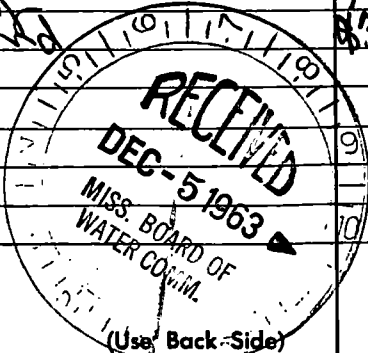

Well No.

1911

A grid of graph paper with a vertical line drawn through it. The grid consists of approximately 10 columns and 15 rows of small squares. A vertical line is drawn through the grid, roughly in the middle. The grid is mostly empty, with some faint markings.