

Harrison
 M 493
 9-67

MISSISSIPPI
 BOARD OF WATER COMMISSIONERS
 416 North State Street
 Jackson, Mississippi 39201

CODED

WATER WELL DRILLERS LOG

9-1 1967 date well completed
 Sutter Well Works firm name
 Harrison county well located

LANDOWNER: de Jean Phylle
 Biloxi, 1513 E. BEACH
 Miss.
 (mailing address)

WELL LOCATION:
 sec. 34 T₁ N R₁ E
 miles in Biloxi East (distance) (direction) (nearest town)

WELL PURPOSE: Industrial
 (home, irrigation, municipal, industrial)


WELL COMPLETION DATA:

- (1) diameter (inches) 8 x 12
- (2) total depth (feet) 792
- (3) static water level (feet) 1 below top of ground.
- (4) casing 1 1/2" steel (material) (depth)
 (size) If telescope see back.
- (5) screen 60' see back (length) (depth to top)
 8" stainless steel (size) (material)
- (6) pump 25 500 (HP) (yield gpm)
 elec. (type power)
- (7) electric log no (yes or no)
 (organization running log)
- (8) how well bottom plugged BPU value

Description of formations encountered	from	to
Shales	0	18
Clay - sand str.	18	119
Sand	119	136
Clay - sand str.	136	360
Sand	360	390
Clay	390	680
Clay	680	732
Clay	732	740
sand	740	782
Clay	782	792

CODED

PURKES
 12/1971

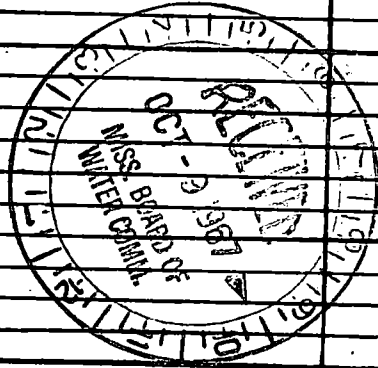

DRILLERS REMARKS:

If well telescopes please sketch and show depths.

GROUND LEVEL

723' of 12" Casing

579' of 8" Casing

30' of screen 8" S.S.

21' of 8" Casing

30' of screen 8" S.S.

10' of Blank
8" Casing

SECTION _____

Please indicate well location X.

ADDITIONAL INFORMATION

If more than one screen, show locations of each on sketch.