

HARRISON
M496
4-19-71

MISSISSIPPI
BOARD OF WATER COMMISSIONERS
416 North State Street
Jackson, Mississippi 39201

CODED

WATER WELL DRILLERS LOG

4/19/71 19 Coastal Drilling Co. Harrison
date well completed firm name county well located
Theodore

LANDOWNER: Joyce J. Haddock
Rt 5 P.O. Box 704
Bilbo, Miss.
(mailing address)

description of formations encountered	from	to
Top Soil	1	5
Red Clay	5	9
Grey Sand	9	60
White Sand	60	135
Dark Blue Clay	135	230
fine white sand	330	350
Dark Blue Clay	350	370
fine white sand	370	410
Dark Water Sand	410	460

WELL LOCATION:
sec. 12 T 2 N R 10 E
S W
1/2 mile S of Celina
(distance) (direction) (nearest town)

WELL PURPOSE: home
(home, irrigation, municipal, industrial)

- WELL COMPLETION DATA:
- (1) diameter (inches) 2"
 - (2) total depth (feet) 460
 - (3) static water level (feet) 20' below top of ground
 - (4) casing glass 450
(material) (depth)
(size) If telescope see back.
 - (5) screen 10' 450
(length) (depth to top)
2" S.S.
(size) (material)
 - (6) pump One 18
(HP) (yield gpm)
Eli
(type power)
 - (7) electric log No
(yes or no)
(organization running log)

CODED

(8) how well bottom plugged
2" back wash valve


DRILLERS REMARKS:
None

MAY 18 1971

MISS. BD. OF
WATER COMMISSIONERS

If well telescopes please sketch and show depths.

GROUND LEVEL

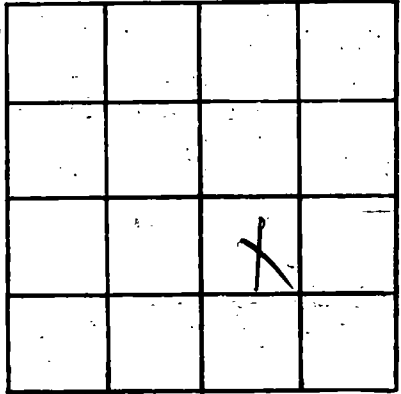

SECTION _____

Please indicate well location X.

ADDITIONAL INFORMATION

A series of horizontal lines for writing additional information.

If more than one screen, show locations of each on sketch.