

HARRISON
M 504
8-11-72

MISSISSIPPI
 BOARD OF WATER COMMISSIONERS
 416 North State Street
 Jackson, Mississippi 39201
 WATER WELL DRILLERS LOG

CODED

8-11 1972 Switchwell Co. Harrison
 date well completed firm name county well located


LANDOWNER: <u>Pedric Buck</u>	description of formations encountered	from	to
<u>Rt 6 Poppo Ferry Rd</u>			
<u>Biloxi, Miss.</u> (mailing address)	clay sand str.	0	23
WELL LOCATION:	clay	23	44
sec. <u>14</u> T. <u>7</u> S. R. <u>12</u> W.	clay-sand mixed	44	65
<u>1</u> miles <u>NW</u> of <u>Biloxi</u>	clay	65	82
(distance) (direction) (nearest town)	sand	82	85
WELL PURPOSE: <u>home</u>	clay	85	86
(home, irrigation, municipal, industrial)	fine sand	86	96
WELL COMPLETION DATA:	clay	96	108
(1) diameter (inches) <u>2"</u>	clay-sand mixed	108	129
(2) total depth (feet) <u>365'</u>	clay	129	146
(3) static water level (feet) <u>37</u> ^{below} above top of ground.	fine sand	146	172
(4) casing <u>galv.</u> <u>365'</u> (material) (depth)	sand	172	174
<u> </u> if telescope see back. (size)	clay	174	297
(5) screen <u>10'</u> <u>355'</u> (length) (depth to top)	fine sand	297	300
<u>008</u> <u>stainless steel</u> (size) (material)	sand	300	304
(6) pump <u>1/2</u> <u>5</u> (HP) (yield gpm)	clay	304	324
<u>ELECT</u> (type power)	sand, gravel	324	365
(7) electric log <u> </u> (yes or no)			
<u> </u> (organization running log)			
(8) how well bottom plugged <u>back</u> <u>pressure valve</u>			
DRILLERS REMARKS:			

CODED

SEP 23 1972

If well telescopes please sketch and show depths.

GROUND LEVEL

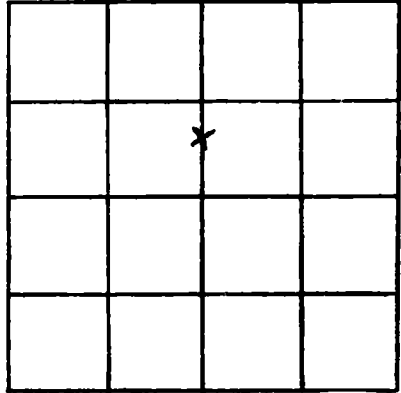

SECTION 14

Please indicate well location X.

ADDITIONAL INFORMATION

If more than one screen, show locations of each on sketch.