

HARRISON  
M505  
5-20-71

MISSISSIPPI  
BOARD OF WATER COMMISSIONERS  
416 North State Street  
Jackson, Mississippi 39201  
WATER WELL DRILLERS LOG

**CODED**

5-20 1971 Switzer Well Co. Harrison  
date well completed firm name county well located

LANDOWNER: <u>Southern River Estate</u>	Description of formations encountered	from	to
<u>Rt. 3 Box 10</u>	<u>CLAY</u>	<u>0</u>	<u>11</u>
<u>Biloxi, Miss. 29532</u> (mailing address)	<u>SAND</u>	<u>11</u>	<u>21</u>
<b>WELL LOCATION:</b>	<u>Sand + gravel</u>	<u>21</u>	<u>41</u>
<u>sec. 9 T. 7 S. R. 9 W.</u>	<u>Mixed</u>	<u>41</u>	<u>61</u>
<u>2</u> miles <u>N</u> of <u>Biloxi</u>	<u>CLAY</u>	<u>61</u>	<u>219</u>
(distance) (direction) (nearest town)	<u>MIXED</u>	<u>219</u>	<u>239</u>
<b>WELL PURPOSE:</b> <u>Trailer Park</u> (home, irrigation, municipal, industrial)	<u>CLAY</u>	<u>239</u>	<u>304</u>
<b>WELL COMPLETION DATA:</b>	<u>SAND</u>	<u>304</u>	<u>319</u>
(1) diameter (inches) <u>4 x 2"</u>	<u>SAND, fair</u>	<u>319</u>	<u>339</u>
(2) total depth (feet) <u>799'</u>	<u>SAND</u>	<u>339</u>	<u>347</u>
(3) static water level (feet) <u>4'06"</u> <u>below</u> <u>above</u> top of ground.	<u>MIXED</u>	<u>347</u>	<u>359</u>
(4) casing <u>Galv.</u> <u>799'</u> (material) (depth)	<u>CLAY</u>	<u>359</u>	<u>437</u>
<u>4"</u> (size) If telescope see back.	<u>STRAKS</u>	<u>437</u>	<u>447</u>
(5) screen <u>20'</u> <u>779'</u> (length) (depth to top)	<u>CLAY</u>	<u>447</u>	<u>538</u>
<u>008</u> <u>stainless steel</u> (size) (material)	<u>SAND</u>	<u>538</u>	<u>543</u>
(6) pump <u>1</u> <u>12</u> (HP) (yield gpm)	<u>CLAY</u>	<u>543</u>	<u>695</u>
<u>ELECT</u> (type power)	<u>SAND</u>	<u>695</u>	<u>799</u>
(7) electric log <u>NP</u> (yes or no)			
(organization running log)			
(8) how well bottom plugged <u>back</u> <u>Pressure Valve</u>			
DRILLERS REMARKS:			

**CODED**

JUN 23 1971

MISS. 37. 25  
WATER


## GROUND LEVEL

125' 05 411

674.05211

20' 25"  
2" SOAEN

**If more than one screen,  
show locations of each on sketch.**

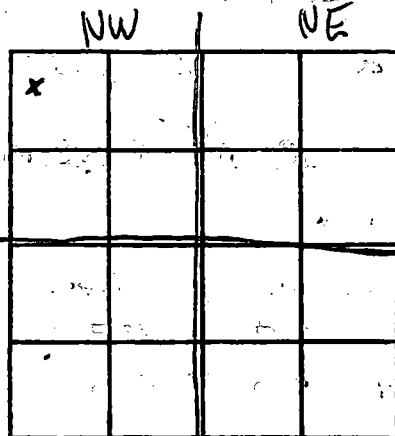

SW

5E

SECTION 9

**Please indicate well location X.**

### ADDITIONAL INFORMATION