




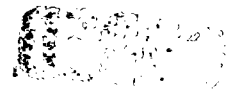


If well telescopes please sketch and show depths.

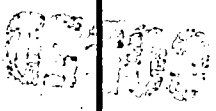

GROUND LEVEL

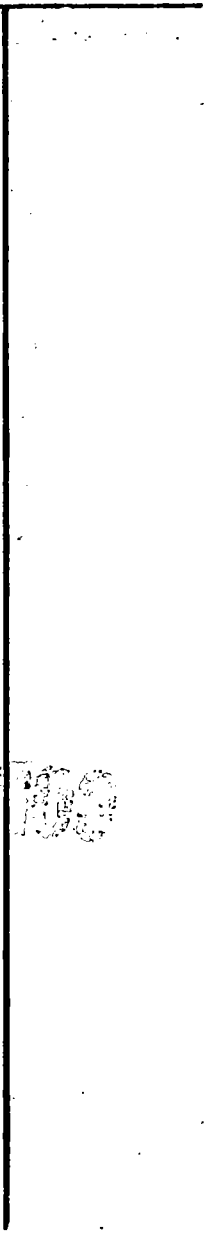

If more than one screen, show locations of each on sketch.

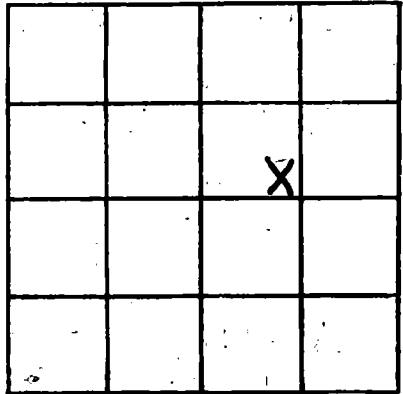

SECTION 9

Please indicate well location X.

ADDITIONAL INFORMATION

Lined area for providing additional information, consisting of approximately 20 horizontal lines.