

HARRISON
M-513
5-2-71

MISSISSIPPI
BOARD OF WATER COMMISSIONERS
416 North State Street
Jackson, Mississippi 39201

WATER WELL DRILLERS LOG

CODED

5/2/71 date well completed
19 Cont'l Drilling Co. firm name
SANTA CRUZ county well located

LANDOWNER: ~~Charles Santa Cruz~~

description of formations encountered

RT 3 Box 640
Bishop, Miss
(mailing address)

description of formations encountered	from	to
Top Soil	1	3
Red Clay	3	7.5
Sugar Sand	7.5	10.6
Blue Sand	10.6	23.0
fine Sand	23.0	27.5
Hard Blue Clay	27.5	56.0
fine Sand	56.0	59.5
Coarse Sand	59.5	61.0
Blue Clay	61.0	65.0
very hard Blue Clay	65.0	7.50
Coarse water sand	7.50	8.14

WELL LOCATION:
sec. 22 T. 7 S. R. 9 E.
10 miles (distance) of (direction) (nearest town)
Newville

WELL PURPOSE: home
(home, irrigation, municipal, industrial)

WELL COMPLETION DATA:

- (1) diameter (inches) 2"
- (2) total depth (feet) 814
- (3) static water level (feet) 22 below top of ground.
- (4) casing glass, 814 (material) (depth)
- (size) If telescope see back.
- (5) screen 15' 799 (length) (depth to top)
- 2" 5.5 (size) (material)
- (6) pump One 16 (HP) (yield gpm)
- 5 hp (type power)
- (7) electric log No (yes or no)
- (organization running log)

CODED

(8) how well bottom plugged 2"
Lead Wire


DRILLERS REMARKS:
None

SEP 15 1971

MISS. BD. OF
WATER COMM.

If well telescopes please sketch and show depths.

GROUND LEVEL

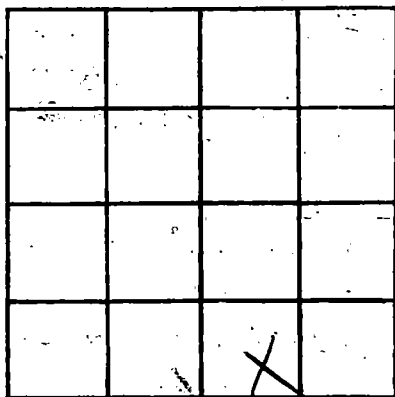

SECTION _____

Please indicate well location X.

ADDITIONAL INFORMATION

If more than one screen, show locations of each on sketch.