

HARRISON
MS19
1-28-72

CODED

MISSISSIPPI
BOARD OF WATER COMMISSIONERS
416 North State Street
Jackson, Mississippi 39201

FLOG #92

FEB 25 1972

WATER WELL DRILLERS LOG

1-28 1972 date well completed
Switzer Well Co. firm name
Harrison county well located

LANDOWNERS: Sunkist Manor
Popp's Ferry Road
Biloxi, Miss.
(mailing address)

WELL LOCATION:
sec 15 T 7 S R 10 W
1 miles N of Biloxi
(distance) (direction) (nearest town)

WELL PURPOSE: Ind. & Agr.
(home, irrigation, municipal, industrial)

WELL COMPLETION DATA:

- (1) diameter (inches) 8"
- (2) total depth (feet) 546'
- (3) static water level (feet) 31' ^{below}/_{above} top of ground.
- (4) casing black pipe 546'
(material) (depth)
- 12
(size) If telescope see back.
- (5) screen 60' 486'
(length) (depth to top)
008 stainless steel
(size) (material)
- (6) pump 25 350
(HP) (yield gpm)
ELECT
(type power)
- (7) electric log YES
(yes or no)
MGS
(organization running log)
- (8) how well bottom plugged Metal
4" backwash valve

description of formations encountered	from	to
SAND	0	10
SOFT CLAY	10	19
SAND & CLAY	19	53
CLAY	53	130
MIXED	130	152
CLAY	152	205
MIXED	205	256
FINE SAND	256	288
CLAY	288	310
FINE SAND	310	378
CLAY	378	398
FINE SAND	398	405
CLAY	405	408
FAIR SAND	408	416
SAND	416	428
MIXED	428	459
FINE SAND	459	474
GD. SAND	474	542
FAIR SAND	542	683

CODED

DRILLERS REMARKS:

If well telescopes please sketch and show depths.

GROUND LEVEL

208 FT of 12 inch


LEAD SEAL 191 FT

305 FT of 8 inch

60 FT of 8 inch
STAINLESS STEEL
WIRE WRAPPED
WELL SCREEN

486 FT

546 FT

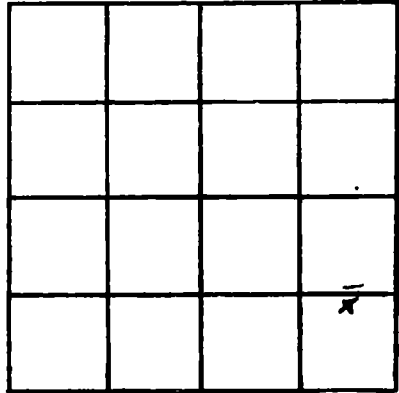

SECTION 15

Please indicate well location X.

ADDITIONAL INFORMATION

If more than one screen,
show locations of each on sketch.