

HARRISON
M 520
7-13-71

MISSISSIPPI
BOARD OF WATER COMMISSIONERS
416 North State Street
Jackson, Mississippi 39201

CODED 1971

WATER WELL DRILLERS LOG

MISS. BD. OF

7/13/71 19 Coastal Drilling Co. Harrison
date well completed firm name county well located

LANDOWNER: T Bird
Rt 1 Box 530
Biloxi, Miss
(mailing address)

description of formations encountered	from	to
top soil	1	3
Blue Clay	3	18
fine water sand	18	37
hard Blue Clay	37	214
fine water sand	214	230
hard Blue Clay	230	300
fine water sand	300	315
fine water sand	315	348

WELL LOCATION:
sec. 5 T 2 N R 9 E
3 miles N of Biloxi
(distance) (direction) (nearest town)

WELL PURPOSE: home
(home, irrigation, municipal, industrial)

WELL COMPLETION DATA:
(1) diameter (inches) 2"
(2) total depth (feet) 348
(3) static water level (feet) 18 below above top of ground.
(4) casing gal 338
(material) (depth)
(size) If telescope see back.
(5) screen 10' 338
(length) (depth to top)
2" SS
(size) (material)
(6) pump One 15
(HP) (yield gpm)
Ele
(type power)
(7) electric log No
(yes or no)
(organization running log)

CODED


(8) how well bottom plugged 2" flush with hole

DRILLERS REMARKS:
None

If well telescopes please sketch and show depths.

011500

GROUND LEVEL

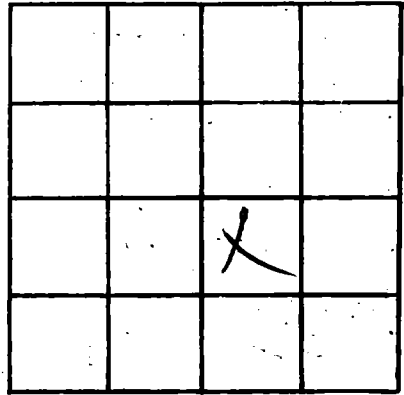

SECTION _____

Please indicate well location X.

ADDITIONAL INFORMATION

011500

If more than one screen, show locations of each on sketch.