

HARRISON
M 527
9-15-72

MISSISSIPPI
 BOARD OF WATER COMMISSIONERS
 416 North State Street
 Jackson, Mississippi 39201

CODED

WATER WELL DRILLERS LOG

9-15 1972 Switzer Well Company Harrison
 date well completed firm name county well located

LANDOWNER: P. P. Redding
Camp 4 Jacks Rd.
Bolepi, Miss. 39532
 (mailing address)

WELL LOCATION:
 sec. 14 T 7 S R 12 W
2 miles NW of B. Lea
 (distance) (direction) (nearest town)

description of formations encountered	from	to
clay	0	23
clay-sand str	23	44
clay	44	54
sand	54	64
clay	64	69
sand	69	83
clay	83	86
sand	86	89
clay	89	193
sand	193	194
clay-sand str	194	215
clay	215	256
fine sand	256	266
clay	266	279
clay-sand str	279	300
clay	300	311
sand	311	315
clay	315	337
sand	337	342
sand, good	342	369

WELL PURPOSE: home
 (home, irrigation, municipal, industrial)

WELL COMPLETION DATA:

(1) diameter (inches) 2"

(2) total depth (feet) 369'

(3) static water level (feet) 35' ^{below} ~~above~~ top of ground.

(4) casing galv. 369'
 (material) (depth)

 If telescope see back.
 (size)

(5) screen 10' 359'
 (length) (depth to top)

008 stainless steel
 (size) (material)

(6) pump 1/2 10
 (HP) (yield gpm)

ELECT
 (type power)

(7) electric log No
 (yes or no)

 (organization running log)

(8) how well bottom plugged check
measure value

CODED


SEP 28 1972

MISS. BD. OF
 WATER COMM.

DRILLERS REMARKS:

If well telescopes please sketch and show depths.

GROUND LEVEL

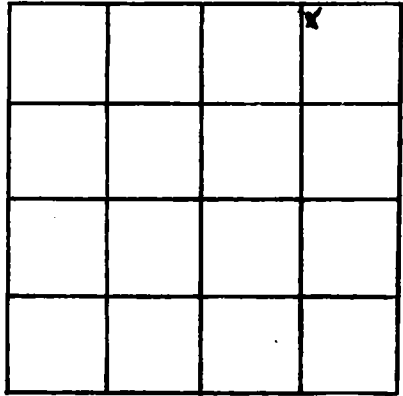

SECTION 14

Please indicate well location X.

ADDITIONAL INFORMATION

If more than one screen, show locations of each on sketch.