

HARRISON
M 529
11-21-71

MISSISSIPPI
BOARD OF WATER COMMISSIONERS
 416 North State Street
 Jackson, Mississippi 39201

WATER WELL DRILLERS LOG

11-21 1971 Switzer Well Co. Harrison
 date well completed firm name county well located

LANDOWNER: James E. Smith Fairview Drive, Edgewater Biloxi, Miss. 39531 (mailing address)	description of formations encountered	from	to
	Sand	0	23
	clay	23	60
	sand	60	72
	clay	72	258
WELL LOCATION:	Sand, fero	258	266
sec. 24 T. 7 S. R. 10 W.	clay	266	316
1/4 miles city of Biloxi (distance) (direction) (nearest town)	Sand	316	321
WELL PURPOSE: Home (home, irrigation, municipal, industrial)	clay	321	334
WELL COMPLETION DATA:	sand, fine	334	342
(1) diameter (inches) 2"	fine sand - clay mix.	342	365
(2) total depth (feet) 576'	clay	365	371
(3) static water level (feet) 26 (below top of ground. above)	Sand	371	381
(4) casing 4" (material) 576' (depth) If telescope see back.	clay	381	397
(5) screen 20' (length) 556' (depth to top) 1/2" stainless steel (material)	sand, fine	397	415
(6) pump 1 (HP) 20 (yield gpm) Eject (type power)	clay	415	513
(7) electric log <u>NO</u> (yes or no) (organization running log)	sand, good	513	535
(8) how well bottom plugged back pressure gauge			
DRILLERS REMARKS:			

JAN 5 1972

MISS. BD. OF
 WATER COMM.

If well telescopes please sketch and show depths.


GROUND LEVEL

85' 05 1/2"

4"x2" BELL
REDUCER

471' 05 2 1/2"

20' 05 2" DIA
2/3 MAPPED
WELL SCREEN

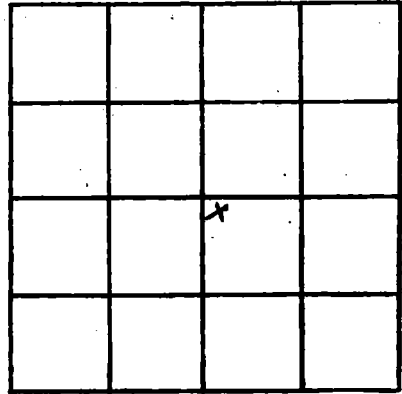

SECTION 28

Please indicate well location X.

ADDITIONAL INFORMATION

If more than one screen,
show locations of each on sketch.