

**HARRISON**  
**M530**  
**11-8-71**

MISSISSIPPI  
 BOARD OF WATER COMMISSIONERS  
 416 North State Street  
 Jackson, Mississippi 39201

WATER WELL DRILLERS LOG

*Nov 8, 71* date well completed      *Central Valley Co. Harrison* firm name      Harrison county well located

LANDOWNER: *C.P. Elder*  
*P.O. 793*  
*Olean Springs, Miss*  
 (mailing address)

WELL LOCATION:  
 sec. *9* T. *7* N. R. *9* E  
*W*  
*Willsville*  
 (distance) miles (direction) of (nearest town)

WELL PURPOSE: *home*  
 (home, irrigation, municipal, industrial)

- WELL COMPLETION DATA:
- (1) diameter (inches) *2"*
  - (2) total depth (feet) *360*
  - (3) static water level (feet) *18* below top of ground above
  - (4) casing *galv* *350*  
 (material) (depth)  
 (size) if telescope see back.
  - (5) screen *10'* *350*  
 (length) (depth to top)  
*2"* *SS*  
 (size) (material)
  - (6) pump *one* *17*  
 (HP) (yield gpm)  
*Ele*  
 (type power)
  - (7) electric log *no*  
 (yes or no)
- (organization running log)


description of formations encountered	from	to
<i>Top Soil</i>	<i>1</i>	<i>3</i>
<i>Blue Clay</i>	<i>3</i>	<i>5</i>
<i>Coarse White Sand</i>	<i>5</i>	<i>18</i>
<i>Red Sand</i>	<i>18</i>	<i>35</i>
<i>Blue Clay</i>	<i>35</i>	<i>48</i>
<i>White Sand</i>	<i>48</i>	<i>60</i>
<i>Blue Clay</i>	<i>60</i>	<i>140</i>
<i>Blue Water Sand</i>	<i>140</i>	<i>160</i>
<i>Blue Clay</i>	<i>160</i>	<i>200</i>
<i>fine water Sand</i>	<i>200</i>	<i>230</i>
<i>Blue Clay</i>	<i>230</i>	<i>300</i>
<i>fine water Sand</i>	<i>300</i>	<i>320</i>
<i>Coarse water Sand</i>	<i>320</i>	<i>360</i>

(8) how well bottom plugged  
*2" back wash Valve*  
 DRILLERS REMARKS: *None*

JAN 30 1972

If well telescopes please sketch and show depths.

GROUND LEVEL

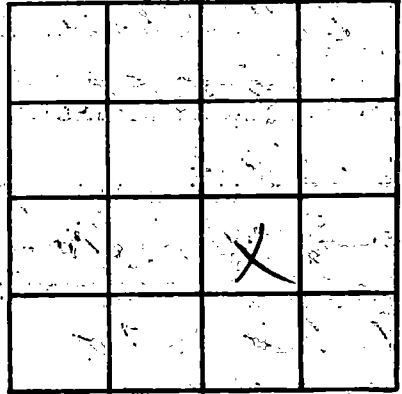

SECTION \_\_\_\_\_

Please indicate well location X.

ADDITIONAL INFORMATION

If more than one screen, show locations of each on sketch.