

HARRISON

M 534

7-14-71

MISSISSIPPI  
 BOARD OF WATER COMMISSIONERS  
 416 North State Street  
 Jackson, Mississippi 39201

FEB 14 1972

WATER WELL DRILLERS LOG

MISS. BD. OF

July 14 71 19  
date well completed

McGill well works  
firm name

Harrison  
county well located

LANDOWNER: Charlie Bond

description of formations encountered

from to

Rt. 5, Box 569

topsoil

0 5

Suffert, Miss.  
(mailing address)

Clay

5 35

WELL LOCATION:

sec. 14 T 7 N R 10 E  
3 miles SW of Loraine  
(distance) (direction) (nearest town)

Sand

45 42

Clay

42 285

WELL PURPOSE: Home  
(home, irrigation, municipal, industrial)

Sand

285 300

WELL COMPLETION DATA:

- (1) diameter (inches) 300' 2"
- (2) total depth (feet) 300'
- (3) static water level (feet) 22' below above top of ground.
- (4) casing gal. 290'  
(material) (depth)  
(size) if telescope see back.
- (5) screen 10' 10'  
(length) (depth to top)  
2" 5.5.  
(size) (material)
- (6) pump 1 8  
(HP) (yield gpm)  
electric  
(type power)
- (7) electric log no  
(yes or no)


**CODED**

- (organization running log)
- (8) how well bottom plugged land  
shank.

DRILLERS REMARKS:

If well telescopes please sketch and show depths.

GROUND LEVEL

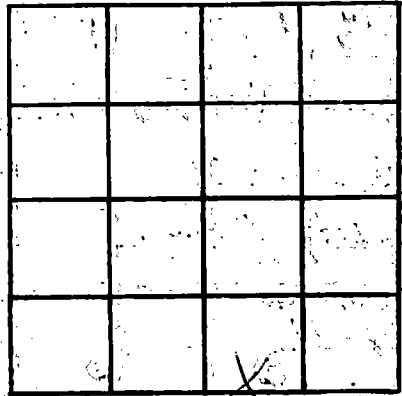

SECTION 14

Please indicate well location X.

ADDITIONAL INFORMATION

If more than one screen, show locations of each on sketch.