

HARRISON
M 535
6-23-71

MISSISSIPPI
 BOARD OF WATER COMMISSIONERS
 416 North State Street
 Jackson, Mississippi 39201

FEB 14 1972

WATER WELL DRILLERS LOG


June 23 71 19 magill well works Harrison
 date well completed firm name county well located

LANDOWNER:	description of formations encountered	from	to
Roy Davis Rt. 5, Box 572 Gulfport Miss. (mailing address)			
WELL LOCATION: sec. 14 T. 7 N R. 18 E 3 miles SW of Mare (distance) (direction) (nearest town)	clay	5	35
WELL PURPOSE: Home (home, irrigation, municipal, industrial)	sand	35	42
WELL COMPLETION DATA: (1) diameter (inches) 300; 2" (2) total depth (feet) 4 (3) static water level (feet) 22 below above top of ground. (4) casing gal. 290' (material) (depth) (size) if telescope see back. (5) screen 10' (length) (depth to top) 2" 5.5. (size) (material) (6) pump 1 4 (HP) (yield gpm) electric (type power) (7) electric log no (yes or no) (organization running log) (8) how well bottom plugged sand 2 shank	clay	42	285
DRILLERS REMARKS:	sand	285	300

CODED

If well telescopes please sketch and show depths.

GROUND LEVEL

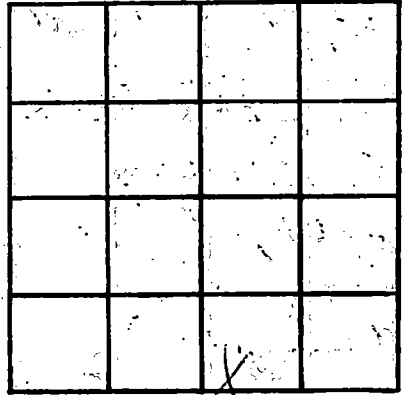

SECTION 14

Please indicate well location X.

ADDITIONAL INFORMATION

If more than one screen, show locations of each on sketch.