

CODED

MISSISSIPPI

BOARD OF WATER COMMISSIONERS

416 North State Street

Jackson, Mississippi 39201

FEB 17 1972

WATER WELL DRILLERS LOG

HARRISON
M537
1-26-72


1-26 1972 Switzer Well Co Harrison
 date well completed firm name county well located

LANDOWNER: Donald Puz	description of formations encountered	from	to
242 3 rd Ave.			
W. Biloxi, Miss. 39532 (mailing address)	clay	0	23
WELL LOCATION:	clay sand streaks	23	44
sec. 14 T. 7 S R. 10 W	clay	44	54
2 miles NW of Biloxi (distance) (direction) (nearest town)	sand	54	65
WELL PURPOSE: Home (home, irrigation, municipal, industrial)	sand, fine	65	87
WELL COMPLETION DATA:	sand	87	103
(1) diameter (inches) 2"	clay	103	151
(2) total depth (feet) 369'	sand-clay mixed	151	172
(3) static water level (feet) 33' ^{below} _{above} top of ground.	clay	172	311
(4) casing galv. 369' (material) (depth)	sand, fine	311	321
4" If telescope see back. (size)	sand, good	321	369
(5) screen 20' 349' (length) (depth to top)			
008, stainless steel (size) (material)			
(6) pump 1 (HP) 14 (yield gpm)			
ELECT (type power)			
(7) electric log NO (yes or no)			
(organization running log)			
(8) how well bottom plugged back pressure valve			
DRILLERS REMARKS:			

CODED

If well telescopes please sketch and show depths.

GROUND LEVEL

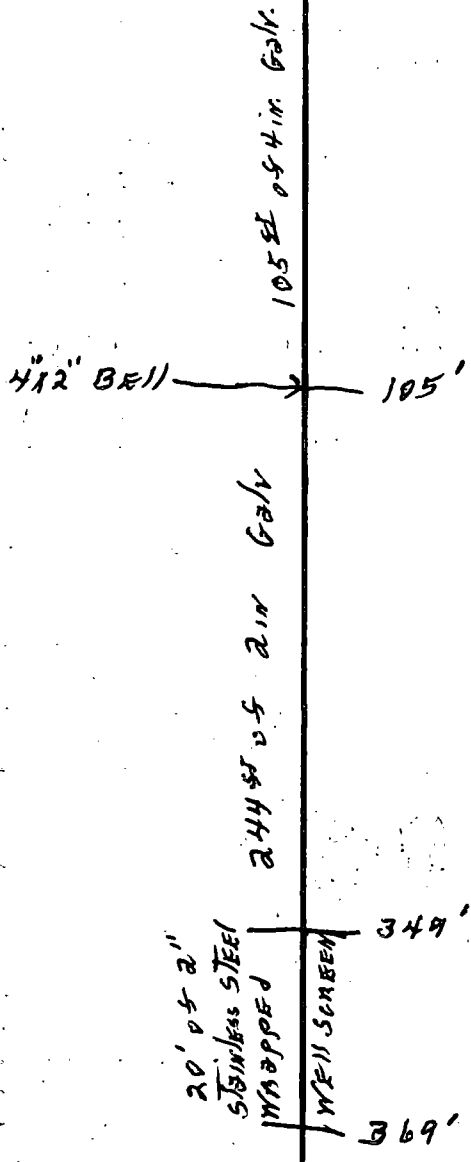

			*

SECTION 14

Please indicate well location X.

ADDITIONAL INFORMATION

If more than one screen, show locations of each on sketch.