


If well telescopes please sketch and show depths.

GROUND LEVEL

105' 105' 05" 4" GALV.
105' Well Reducer

579' 20' 05" 2" GALV.
579' 20' 05" 2" GALV.
STEEL
WIRE MESH
WELL SCREEN

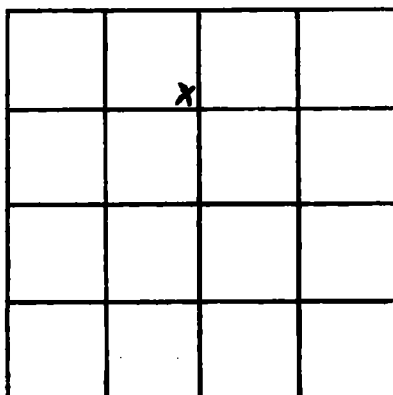

SECTION 23

Please indicate well location X.

ADDITIONAL INFORMATION

If more than one screen,
show locations of each on sketch.