

HARRISON
M 548
10-18-72

MISSISSIPPI
BOARD OF WATER COMMISSIONERS
416 North State Street
Jackson, Mississippi 39201
WATER WELL DRILLERS LOG

Oct 18 1972 M & B Drilling Co. Harrison
date well completed firm name county well located

LANDOWNER:
Timberlane V. Traylor Pk.
Poppo Ferry Rd Biloxi, Miss
(mailing address)

WELL LOCATION:
sec. 17 T. 7 S. R. 9 W.
1 miles W of McBenville
(distance) (direction) (nearest town)

WELL PURPOSE: Traylor Pk
(home, irrigation, municipal, industrial)

WELL COMPLETION DATA:

(1) diameter (inches) 10" X 6"
(2) total depth (feet) 855
(3) static water level (feet) 10 below above top of ground.
(4) casing Steel 805
(material) (depth)
10 X 6 If telescope see back.
(size)
(5) screen 50 805
(length) (depth to top)
6" Stainless Steel 316
(size) (material)
(6) pump 20 250
(HP) (yield gpm)
220V 3Ø
(type power)
(7) electric log No
(yes or no)

(organization running log)



description of formations encountered	from	to
Clay	0	15
Sand	15	25
White Clay	25	70
Blue Clay	70	110
Brown Sand	110	160
Blue Clay	160	245
Sand	245	260
Clay	250	265
Sand	265	275
Blue Clay	275	358
Sand	358	395
Blue Clay	395	515
Fine Sand	515	520
Blue Clay	520	575
Sand	575	632
Blue Clay	632	750
Sand & Clay Br.	750	760
Sand with Fine Blue Clay	760	800
Blue Clay	800	805
Blue Clay	805	855

(8) how well bottom plugged
6" Rod Wash Valve

DRILLERS REMARKS:

OCT 21 1972

If well telescopes please sketch and show depths.

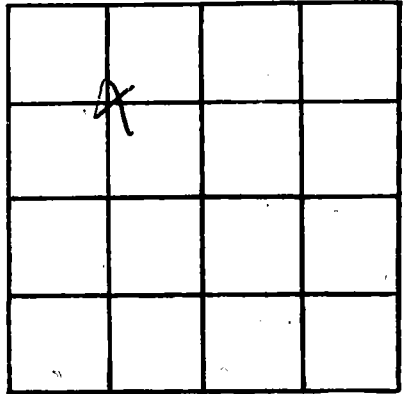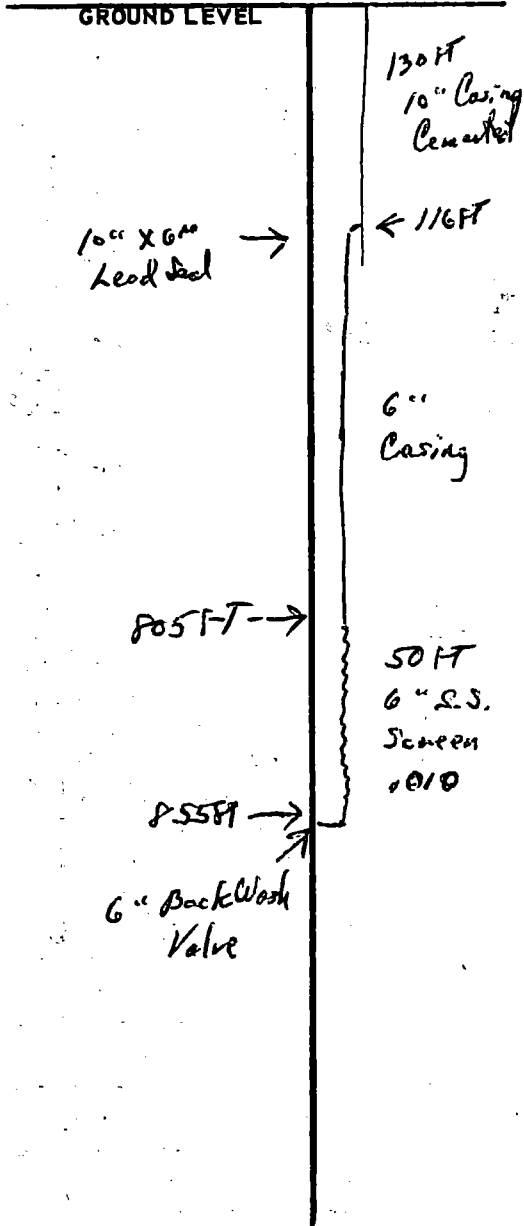

SECTION 17

Please indicate well location X.

ADDITIONAL INFORMATION

Well Pumping 70gpm w/ 1/4
HP Compressor

If more than one screen, show locations of each on sketch.